



ADDENDUM No. 1

OCTOBER 8, 2015

Solicitation Title: 32' Traffic Circle Project

Solicitation No.: IFB No. 43-07-15 Opening Date: October 14, 2015 at 3:30 pm

Attention all potential bidders:

- MUST Addendum:** Read carefully and follow all instructions. Information included in this Addendum will have a material impact on the submittal for this solicitation. All "MUST" addenda are considered a matter of responsiveness. "MUST" addenda must be returned with your Bid submittal or acknowledged on Form "A-5" attached to this addendum. Failure of a Submitter to acknowledge the addenda shall be cause for rejection of the bid.

To all prospective bidders, please note the following changes and clarifications:

1. All instances of "32' Traffic Circle Project" should be changed to "40' Traffic Circle Project"
2. Price Proposal Form on pages 38 - 40 should be replaced with the attached Price Proposal (Attachment A)

Request for Information Questions/Clarification:

Q.1 "On Drawing No. 2 of 8 the cross section shows Type B curb inside and outside. The plan shows Type B and D. Please clarify"

A.1 See revised attached drawing 2 of 8 for clarification. (Attachments B and C)

Q.2 "Could you please provide us with a new cross section showing the items below:
A) Color, thickness and pattern of the pavers
B) What type of material we will install under the pavers and thickness"

A.2 A) Color and pattern of pavers will be reviewed and approved by the City of North Miami prior to installation. See the new PAVER DETAIL on drawing 2 of 8 (Attachments B and C) for the thickness of the pavers.

B) See new PAVER DETAIL on drawing 2 of 8 for the type and thickness of materials to be installed under the pavers. (Attachments B and C)

Q.3 “The plan does not show the elevations.”

A.3 The proposed elevation is not shown however the existing elevation is shown within the details and dimensions for the traffic circle and associated features on drawing 2 of 8. Proposed grading shall match existing at the construction limit.

Q.4 “What type of curb will be at the islands?”

A.4 As specified in the updated drawing 2 of 8 (Attachments B and C), the curb at the islands shall be type “D” as shown by the added call-out, “CONST. TYPE ‘D’ CURB FOR ALL MEDIANS TYP.”

Q.5 “Will we be able to close the intersections during the project?”

A.5 The complete closure of the intersection will not be allowed throughout the duration of the project. Periodic closure may be allowed on a case by case basis by the City of North Miami and Miami Dade County. The contractor will be required to provide for the City’s and County’s approval, a MOT plan which may include re-routing of local traffic prior to the commencement of construction.

Q.6 “Is International Experience accepted?”

A.6 No, International Experience will not be accepted.

Q.7 “Does the City own any property near site which could be negotiated for project storage?”

A.7 No, the City will not provide for project storage. Contractors shall make private arrangements for project storage.

Q.8 Is there required SBE% on this project?

A.8 No, but there is a local preference clause section in bid.

Q.9 How would a prime get access to a list of subcontractors within the City of North Miami?

A.9 Attached is a list of local construction companies. This does not guarantee that your company will rate Local Preference. (Attachment D)

All other terms, conditions and specifications remain unchanged for this solicitation.

End of Addendum



PRICE PROPOSAL FORM
32' Traffic Circle Project
IFB No. 43-07-15

REVISED PRICE PROPOSAL

The prices listed below shall include the total cost to complete the Services including but not limited to materials, labor, equipment, bonds, insurances, purchasing & installation and all other associated costs, etc., as necessary to ensure proper delivery of Services and/or products requested by the City of North Miami.

Bidder is required to submit pricing on all signs or may be rejected.

TRAFFIC CIRCLE 1 – NW 133 Street & NW 11 Avenue					
Item #	Description	Unit	Estimated Quantity	Unit Price	Total
1	Mobilization	LS	1	\$	\$
2	Maintenance of Traffic	LS	1	\$	\$
3	Clearing & Grubbing	LS	1	\$	\$
4	Type “F” Curb & Gutter	LF	586	\$	\$
5	Type “D” Curb	LF	368	\$	\$
6	Type “B” Curb	LF	245	\$	\$
7	6” Limerock	SY	33	\$	\$
8	Asphalt Type S-1	SY	33	\$	\$
9	Mill & Resurface	SY	850	\$	\$
10	4” Thick Concrete	SY	72	\$	\$
11	6” Thick Concrete - Driveway	SY	38	\$	\$
12	Brick Paver	SY	60	\$	\$
13	ADA Detectable Warning Pad	EA	16	\$	\$
14	24” White Stripe	LF	185	\$	\$
15	12” White Stripe	LF	185	\$	\$
16	6” Yellow Stripe	LF	1050	\$	\$
17	Install Sign & Post w/ breakaway	EA	20	\$	\$
18	Remove Existing Sign & Post	EA	4	\$	\$
19	Irrigation System	LS	1	\$	\$
20	Directional Bore, Less than 6”	EA	2	\$	\$
21	Top Soil	SY	94	\$	\$
22	Phoenix Sylvestris 8 – 10’ Triangle Cut – Certified Florida #1 or better	EA	1	\$	\$
23	Cap Rocks	SY	4	\$	\$

24	Lantana "Gold/Yellow" (1 GAL)	EA	30	\$	\$
25	Parsony Jupiter (5 GAL)	EA	48	\$	\$
26	Electrical	LS	1	\$	\$
27	Adjust Drainage Manhole to Proposed Grade	EA	1	\$	\$
28	Adjust Drainage Inlet to Proposed Grade	EA	1	\$	\$
29	Contingency (10%)	LS	1	\$	\$
Sub Total (Items 1-29):					\$

TRAFFIC CIRCLE 2 – NE 131 Street & NE 12 Avenue

Item #	Description	Unit	Estimated Quantity	Unit Price	Total
30	Mobilization	LS	1	\$	\$
31	Maintenance of Traffic	LS	1	\$	\$
32	Demolition, Clearing & Grubbing	LS	1	\$	\$
33	Type "F" Curb & Gutter	LF	600	\$	\$
34	Type "D" Curb	LF	368	\$	\$
35	Type "B" Curb	LF	245	\$	\$
36	6" Limerock	SY	52	\$	\$
37	Asphalt Type S-1	SY	52	\$	\$
38	Mill and Resurface	SY	850	\$	\$
39	4" Thick Concrete	SY	105	\$	\$
40	Brick Paver	SY	60	\$	\$
41	ADA Detectable Warning Pad	EA	16	\$	\$
42	24" White Stripe	LF	185	\$	\$
43	12" White Stripe	LF	185	\$	\$
44	6" Yellow Stripe	LF	1050	\$	\$
45	Install Sign & Post w/ breakaway	EA	20	\$	\$
46	Remove Existing Sign & Post	EA	4	\$	\$
47	Irrigation System	LS	1	\$	\$
48	Directional Bore, Less than 6"	EA	2	\$	\$
49	Top Soil	SY	94	\$	\$
50	Phoenix Sylvestris 8 – 10' Triangle Cut – Certified Florida #1 or better	EA	1	\$	\$
51	Cap Rocks	SY	3	\$	\$
52	Lantana "Gold/Yellow" (1 GAL)	EA	25	\$	\$
53	Parsony Jupiter (5 GAL)	EA	40	\$	\$
54	Electrical	LS	1	\$	\$
55	Adjust Drainage Manhole to Proposed Grade	EA	1	\$	\$
56	Contingency (10%)	LS	1	\$	\$
Sub Total (Items 30-56):					\$

57	Allowance (for permitting; special city fees, unforeseen conditions; repair of existing facilities). Payment for all allowance items must be accompanied by original invoice at cost, with no mark up allowed.	\$10,000
Grand Total (Items 1-57):		\$
Completion Time in Calendar Days:		_____ Days

The price listed in the Price Proposal Form shall include the total cost to complete the Work including but not limited to materials, labor, equipment, bonds, insurances, etc, as necessary to ensure proper delivery of the design-build Services and product requested by the City of North Miami.

Company Name

Offeror Signature





Date:

Name: (Please Print)


Title:

PLEASE SUBMIT PRICES F.O.B. DESTINATION, LESS TAXES, DELIVERED IN
CITY OF NORTH MIAMI, FLORIDA





NOTE: City of North Miami is exempt from all taxes (Federal, State, and Local). Bid price should be less all taxes. Tax Exemption Certificate furnished upon request.

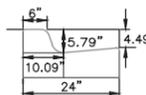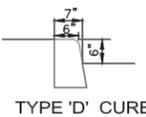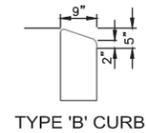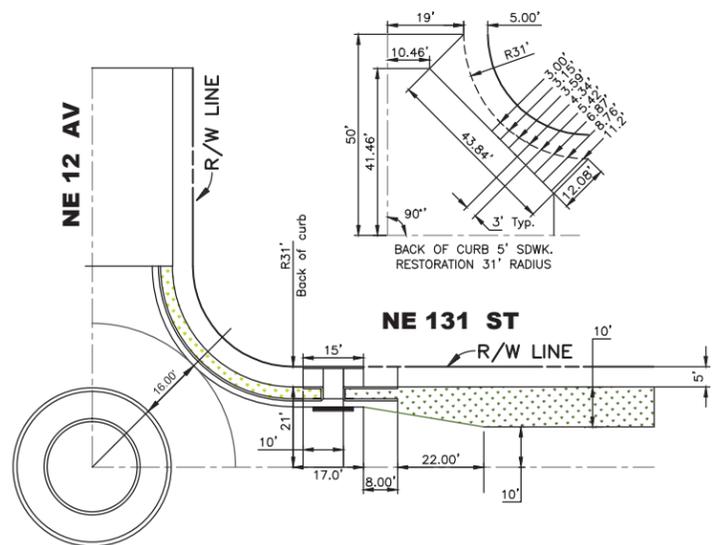

See Miami Dade County Public Works Manual, Standard Road Details: Curbing R 14.1 to R 14.6

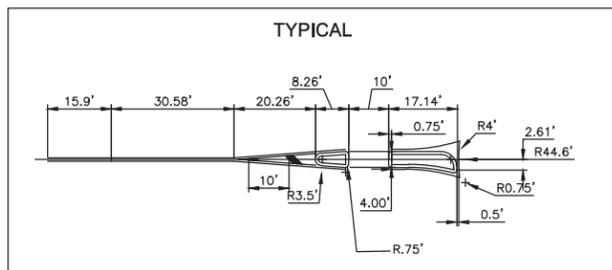

NOTE: TYPICAL PER FHWA ROUNDABOUT GUIDELINE, MINIMUM BUFFER BETWEEN BACK OF CURB AND FRONT OF SIDEWALK TO BE 2'.

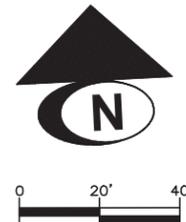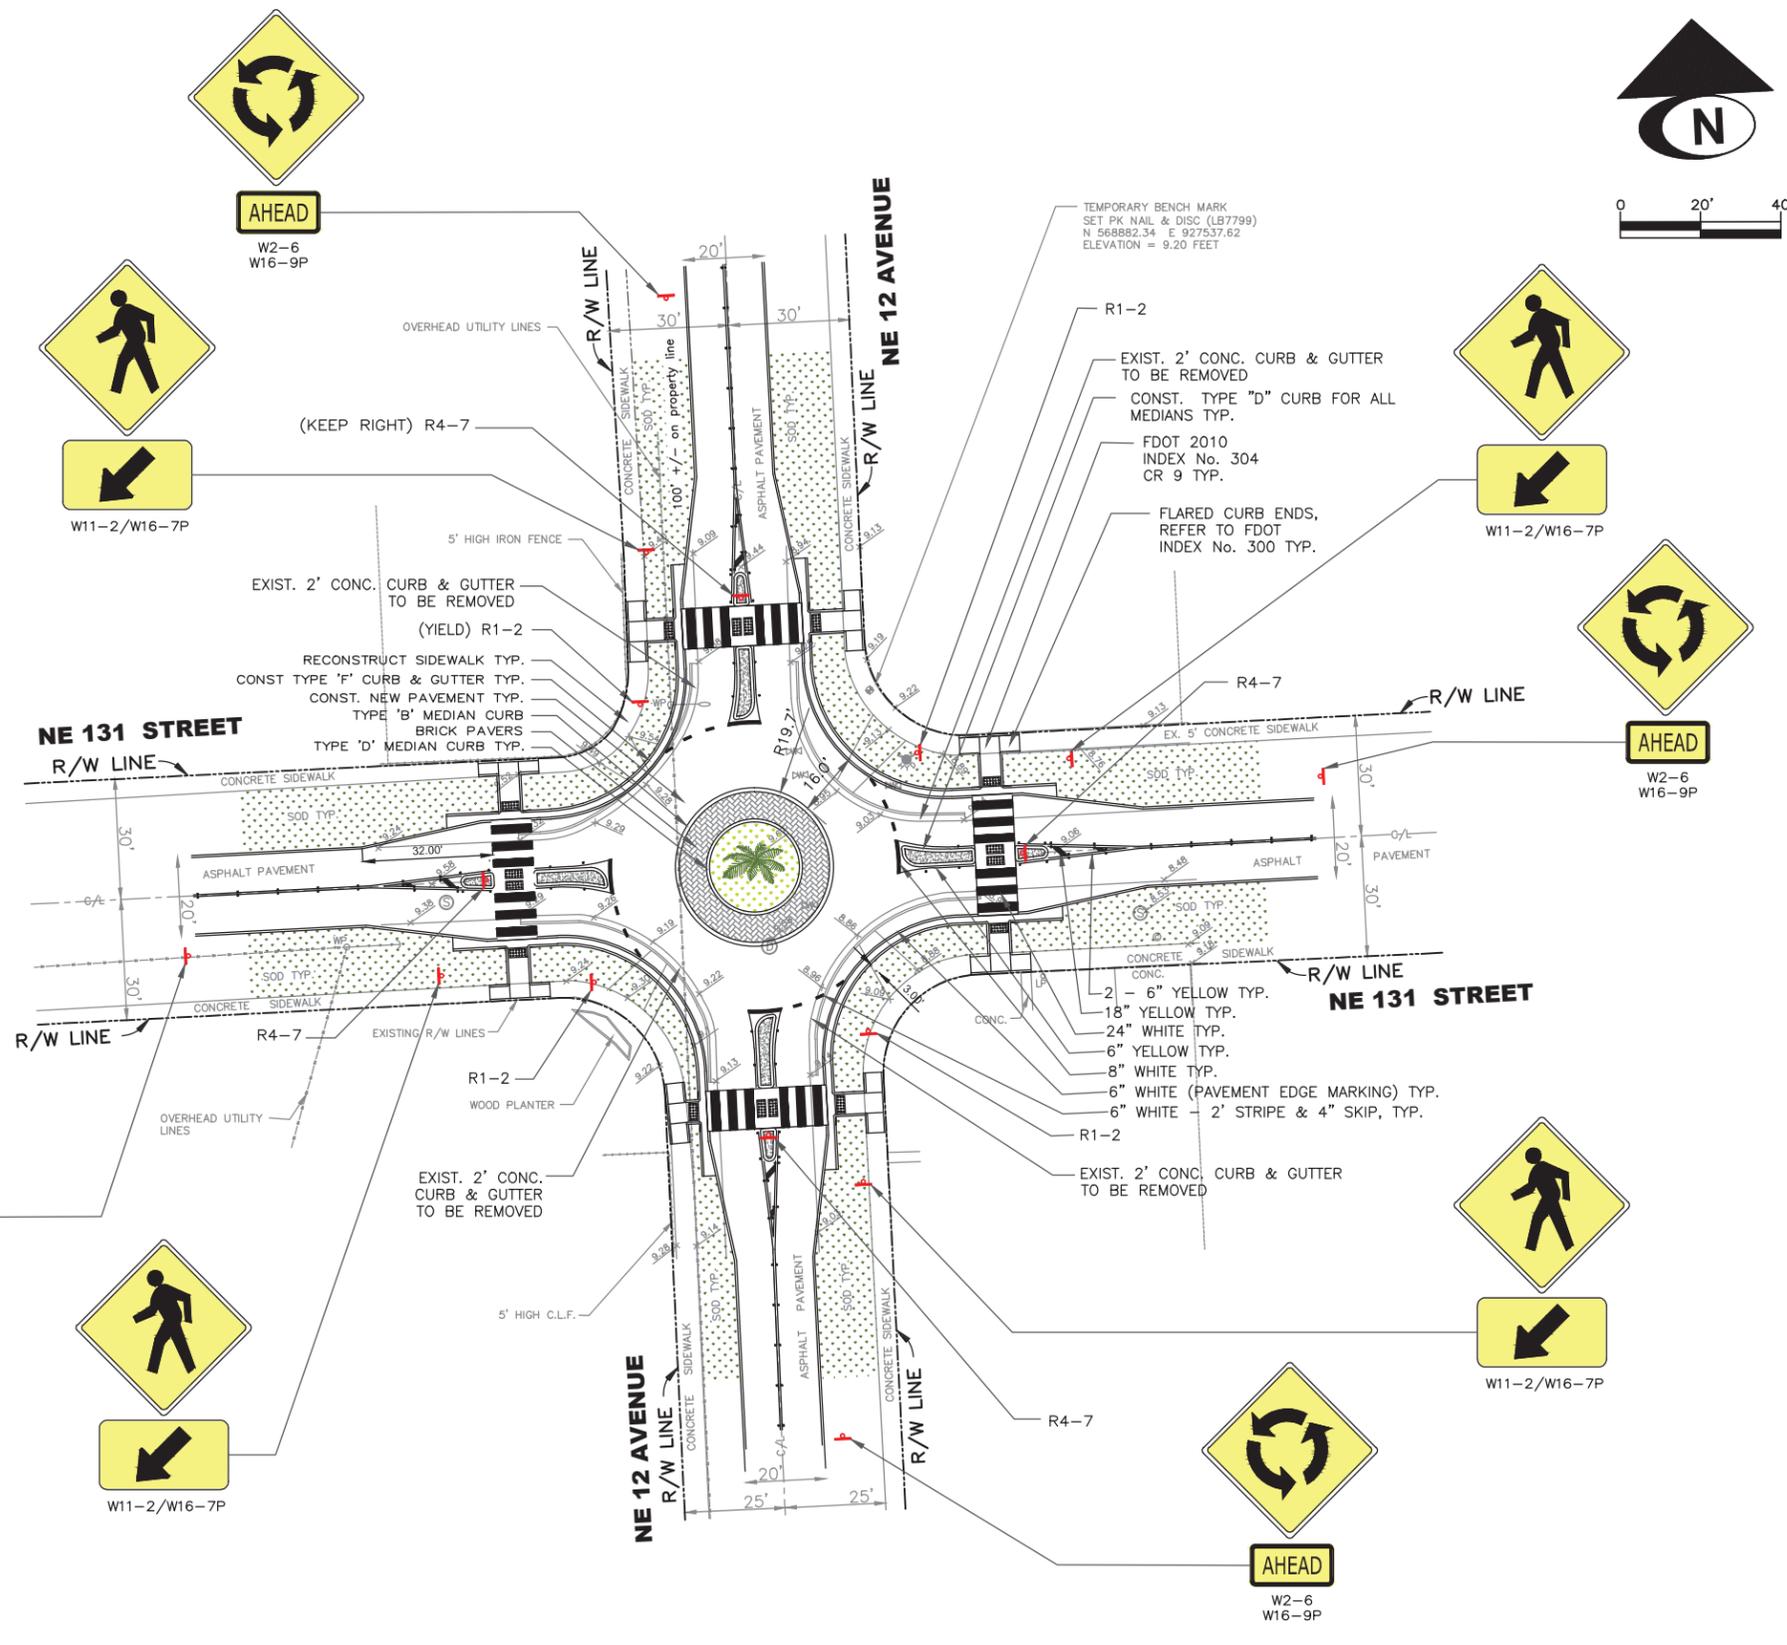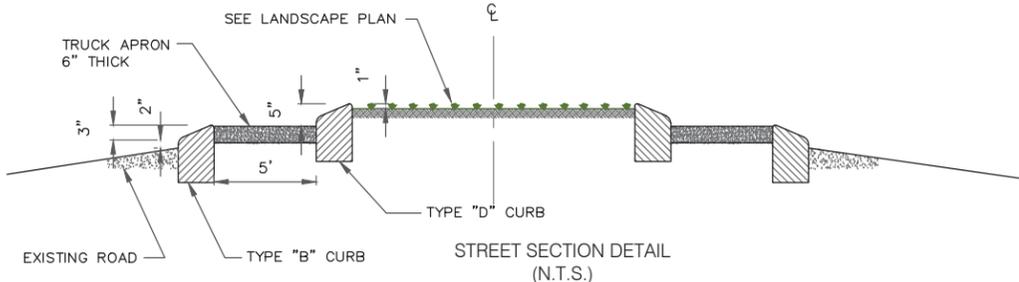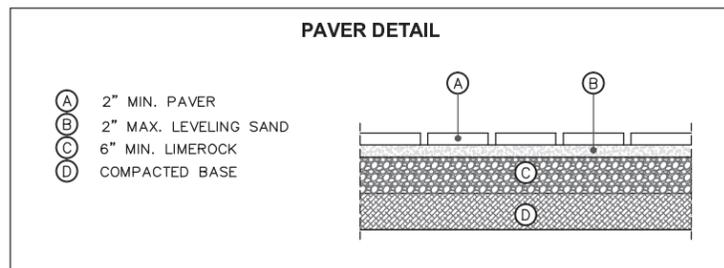





CHECKED BY: GREGORY NETTO, P.E.
PREPARED BY: W. FARYNA-A.
DATE: SEPTEMBER, 2015
DWG No.: 2 OF 8

SIGNED AND SEALED BY:
CHUKS OKEREKE, P.E. (#60204)


PROPOSED TRAFFIC CIRCLE INTERSECTION AT NE 12 AVENUE AND NE 131 STREET







CITY OF NORTH MIAMI
PUBLIC WORKS DEPARTMENT
NORTH MIAMI, FLORIDA

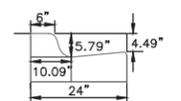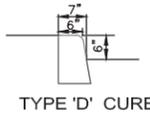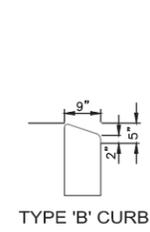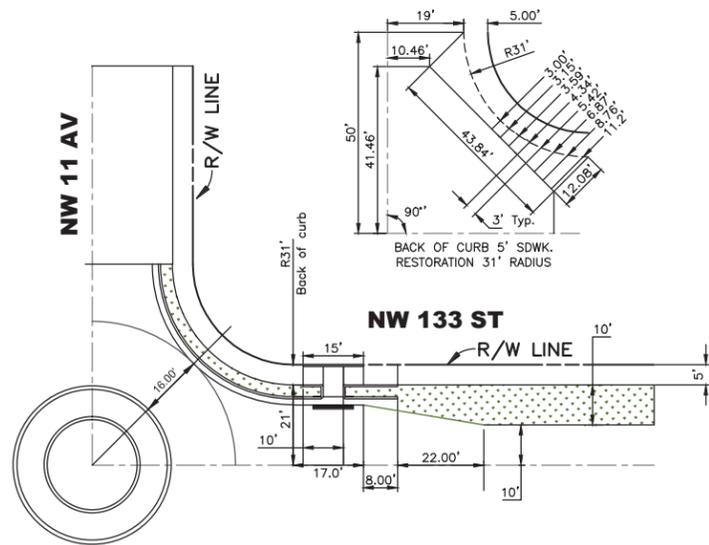

See Miami Dade County Public Works Manual, Standard Road Details: Curbing R 14.1 to R 14.6

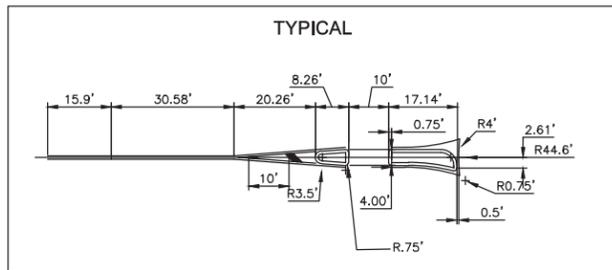

NOTE: TYPICAL PER FHWA ROUNDABOUT GUIDELINE, MINIMUM BUFFER BETWEEN BACK OF CURB AND FRONT OF SIDEWALK TO BE 2'.

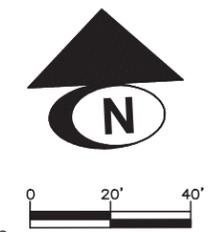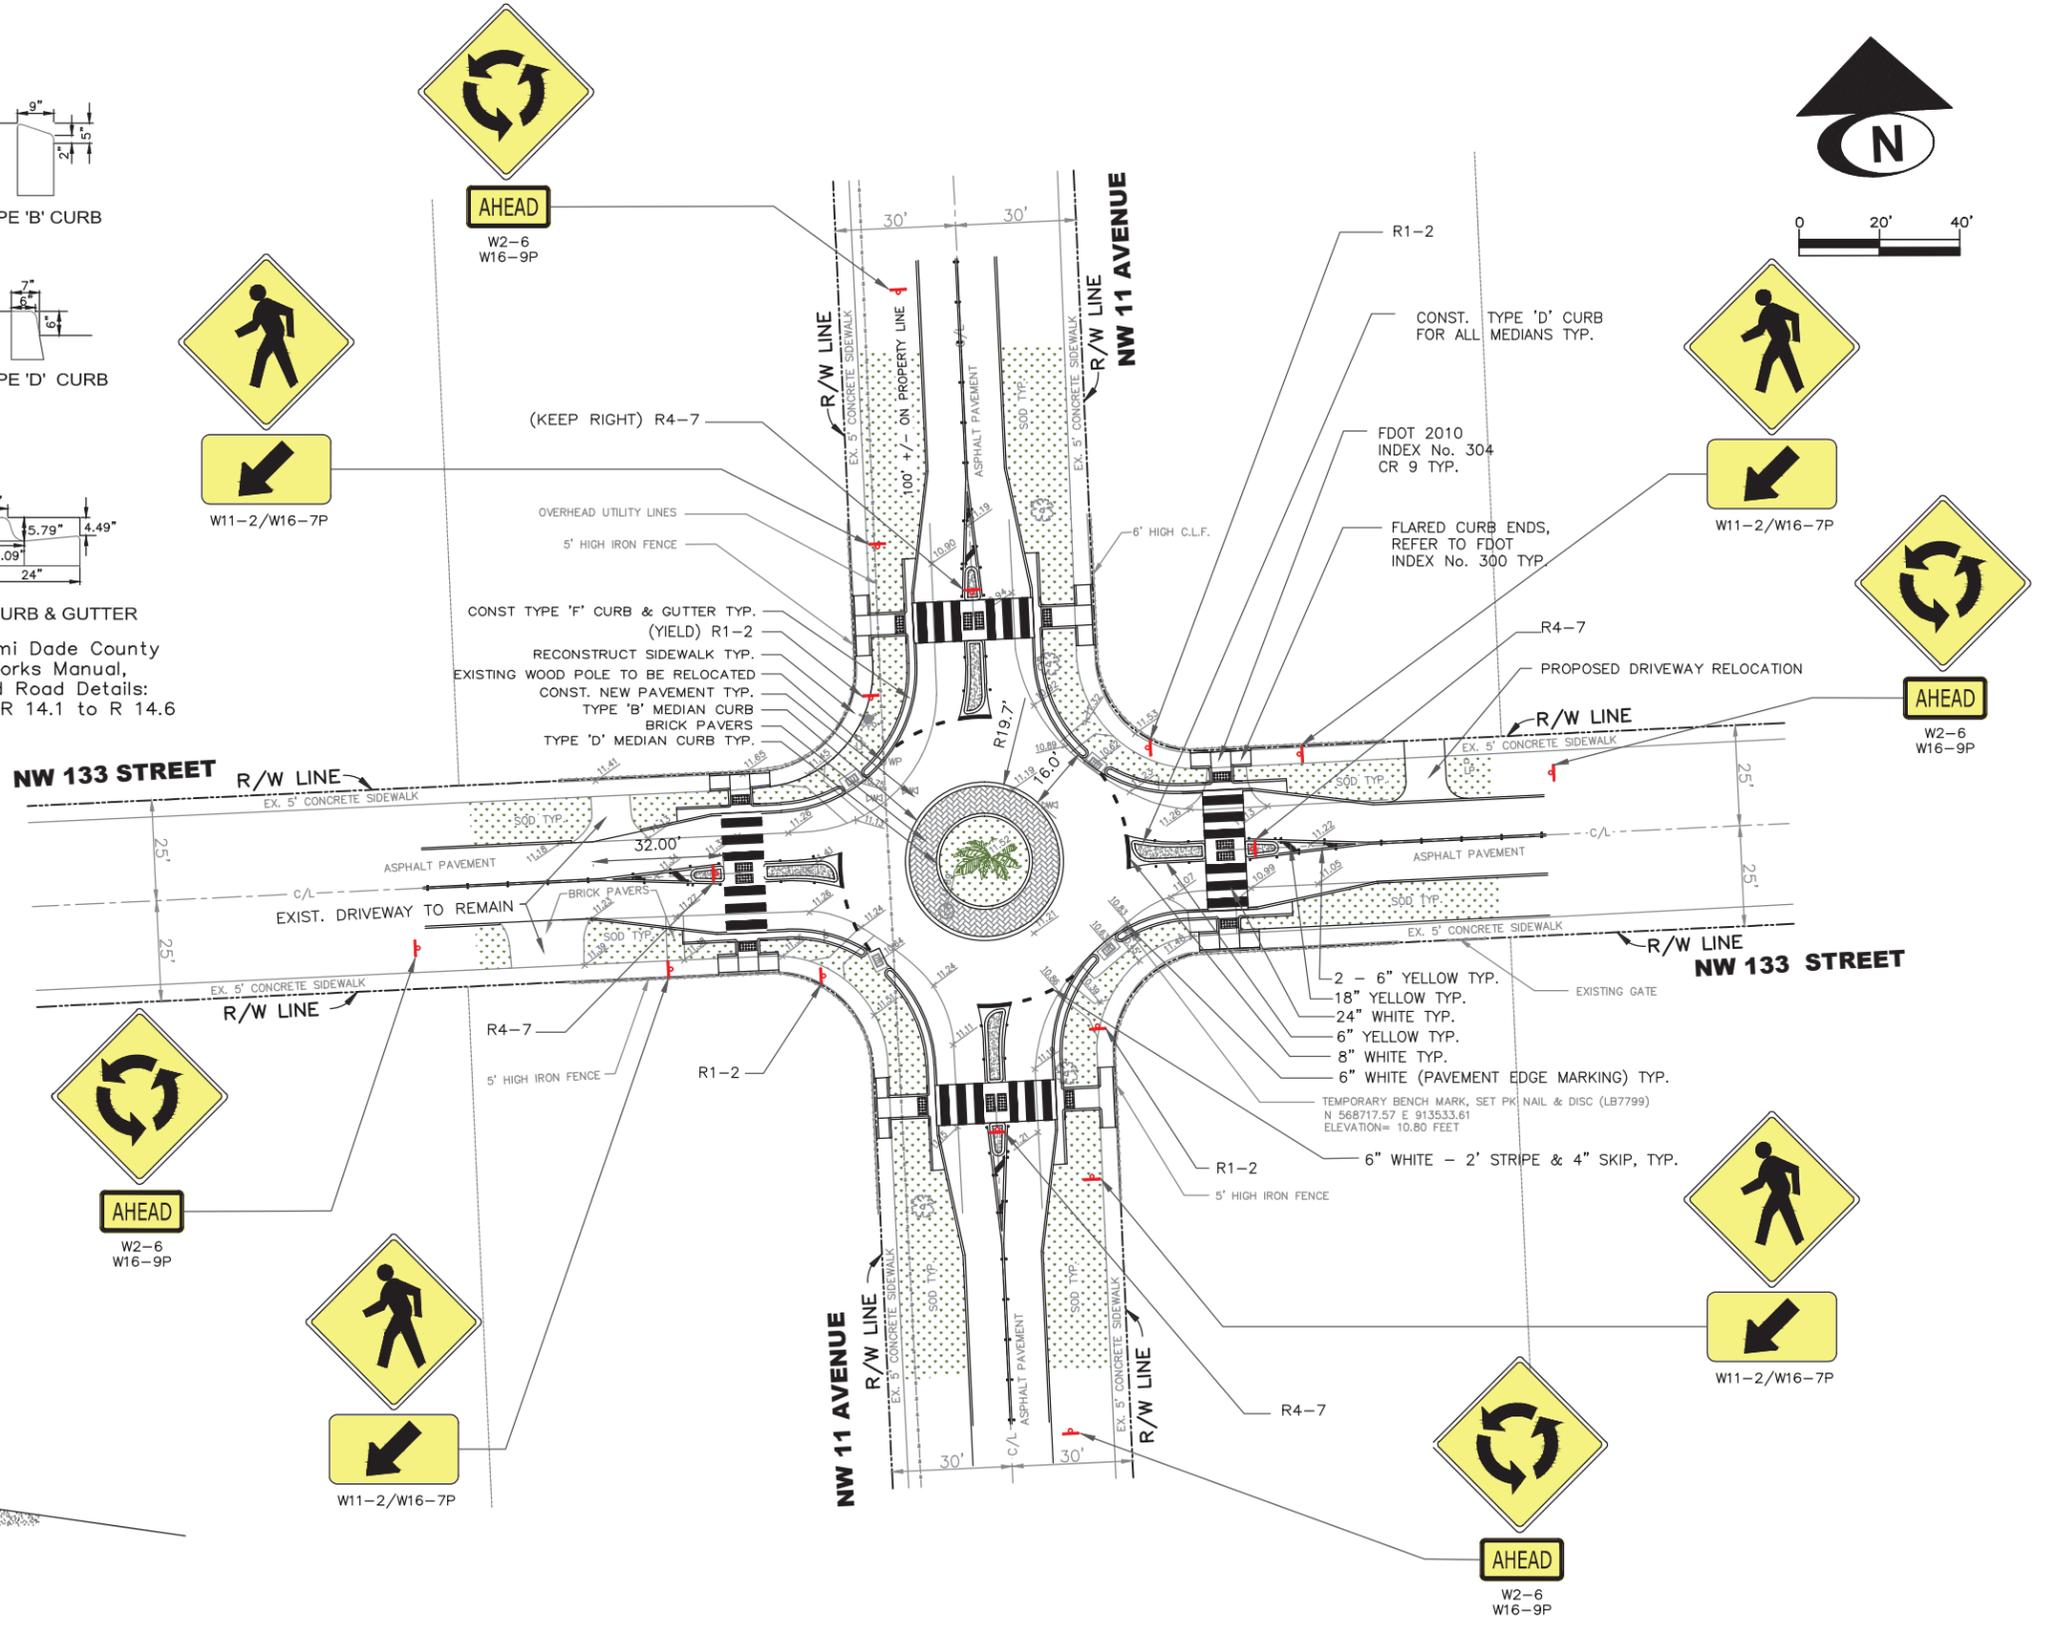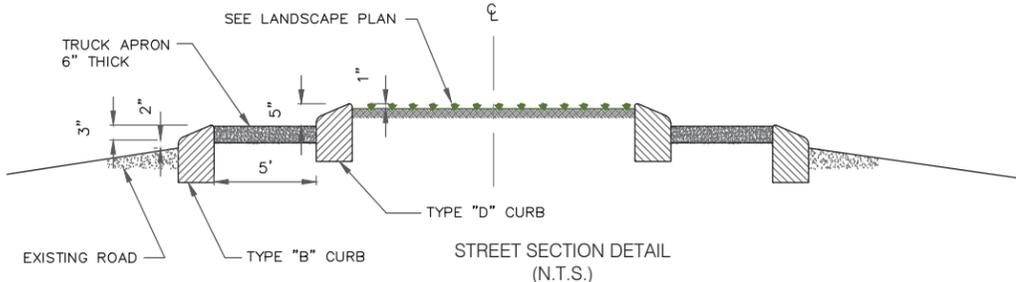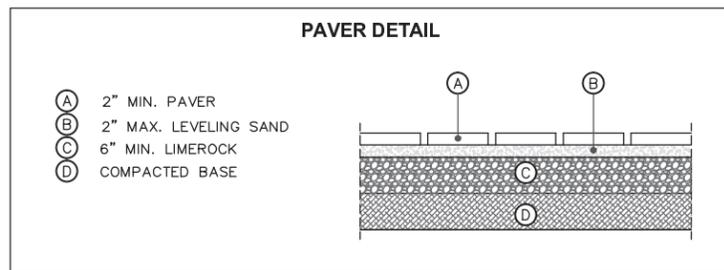

CHECKED BY:	GREGORY NETTO, P.E.	SIGNED AND SEALED BY:	
PREPARED BY:	W. FARYNA-A.		
DATE:	SEPTEMBER, 2015		
DWG No.:	2 OF 8		CHUKS OKEREKE, P.E. (#60204)

PROPOSED TRAFFIC CIRCLE INTERSECTION AT NW 11 AVENUE AND NW 133 STREET



CITY OF NORTH MIAMI
PUBLIC WORKS DEPARTMENT
NORTH MIAMI, FLORIDA

Attachment D – Local North Miami Construction Companies

Full Name	DBA Name
ALL ABOUT CONSTRUCTION, INC.	ALL ABOUT CONSTRUCTION
ATLANTIC COAST CONSTRUCTION, INC.	ATLANTIC COAST CONSTRUCTION
BECNAN CONSTRUCTION SERVICES	BECNAN CONSTRUCTION SERVICES
BOYD CONSTRUCTION GROUP, LLC	BOYD CONSTRUCTION GROUP
CHARLES EVERS CONSTRUCTION CONSULTANT INC	CHARLES EVERS CONSTRUCTION CONSULTANT INC
COASTAL CONSTR. & CONSULTANTS CORP	COASTAL CONSTR. & CONSULTANTS CORP
D2 CONSTRUCTION INC	D2 CONSTRUCTION INC
DAKOTA CONSTRUCTION & REMODELING, CORP	DAKOTA CONSTRUCTION & REMODELING
DOUBLE DIAMOND CONSTRUCTION, INC	DOUBLE DIAMOND CONSTRUCTION, INC
DOZIER AND DOZIER CONSTRUCTION, INC.	DOZIER AND DOZIER CONSTRUCTION
E L C I CONSTRUCTION GROUP INC	E L C I CONSTRUCTION GROUP INC
EJD CONSTRUCTION	EJD CONSTRUCTION CONTRACTORS & INVESTMENT
EMILIO & SONS REMODLING INC	EMILIO & SONS REMODLING INC
GREEN, DONALD M	COASTAL CONSTR. & CONSULTANTS CORP
LB CONSTRUCTION OF SOUTH FLORIDA, INC.	LB CONSTRUCTION OF SOUTH FLORIDA
LOGIC BUILDERS, INC.	LOGIC BUILDERS
LOUMINEL GENERAL CONTRACTOR, LLC	LOUMINEL GENERAL CONTRACTOR, LLC
LYNDON ROOFING & CONSTRUCTION LLC	LYNDON ROOFING & CONSTRUCTION LLC
MAX SOUTH CONSTRUCTION, INC.	MAX SOUTH CONSTRUCTION, INC.
MORRISSEY CONSTRUCTION	MORRISSEY CONSTRUCTION COMPANY
NORTH STAR CONTRACTORS INC	EX DATALINX INC
ORONI INC.	ORONI INC.
PIPER CONSTRUCTION	EVAN PIPER ENTERPRISES, INC.
PRESTIGE CONSTRUCTION ENGINEERING GROUP, LLC	PRESTIGE CONSTRUCTION ENGINEERING GROUP, LLC
PROGRESSO CONSTRUCTION ASSOCIATES GROUP OF MIAMI IN	PROGRESSO CONSTRUCTION ASSOCIATES GROUP OF MIAMI INC
QUIRINO CONST CO	QUIRINO CONST CO
RCI DESIGN & CONSTRUCTION INC	RCI DESIGN & CONSTRUCTION INC
REED (E.W.) INC.	REED (E.W.) INC.
SA CONSULTANTS, LLC	SA CONSULTANTS
SOLUTIONS CAPITAL GROUP, INC.	ALL FLORIDA CONSTRUCTION & ROOFING
TATE (STANLEY) BUILDERS, INC.	TATE (STANLEY) BUILDERS, INC.
TATE DEVELOPMENT CORPORATION	TATE DEVELOPMENT CORPORATION
TAURUS GENERAL CONTRACTING, INC.	TAURUS GENERAL CONTRACTING
TJ OF MIAMI INC	TJ OF MIAMI INC
TOUSSAINT (A.R.) & ASSOC., INC	TOUSSAINT (A.R.) & ASSOC., INC
TRACY LUXURY CONSTRUCTION CORP.	TRACY LUXURY CONSTRUCTION
VARGAS GENERAL CONSTRUCTION, LLC	VARGAS GENERAL CONSTRUCTION