

SANITARY SEWER SERVICES AGREEMENT

THIS WATER & SEWER SERVICES AGREEMENT ("Agreement") is made and entered this 22 day of November, 2023, by and between the **CITY OF NORTH MIAMI**, a Florida municipal corporation ("City"), and **Tabernacle of Glory, Inc.** ("Customer").

WHEREAS, the City Water & Sewer Division of the Public Works Department has existing facilities, including but not limited to, sewer mains and improvements ("City Facilities") and Customer has constructed certain facilities, including but not limited to, sewer lateral and improvements, located in the clouded area on the attached Exhibit "A" that connect to the City Facilities. The facilities constructed by Customer are hereinafter referred to as the Facilities; and

WHEREAS, Customer owns property in unincorporated Miami-Dade County, which is more fully described in the legal description attached hereto as Exhibit "B" ("Customer's Property"); and

WHEREAS, the Customer desires to obtain sanitary sewer service ("Service") to Customer's Property utilizing the City Facilities; and

WHEREAS, the City desires to provide such Service upon the terms and conditions set forth herein.

NOW, THEREFORE, in consideration of the mutual promises contained herein, the parties agree as follows:

1. The Service shall be permitted by the City from the Customer's Property to the City Facilities, as described in Exhibit "A".
2. The complete plans and specifications must be approved by the City Engineer for Facilities to service the described area and the connection to the City Facilities ("Connection") shall be prepared by the Customer's Professional Engineer who shall be registered in the State of Florida. All construction shall be in strict conformity with the final plans and specifications as approved by the City's Engineer. The City, its engineer, or other representative, shall have the right to inspect any and all portions of the Facilities whether in Public Right-of-Way or on private property, and upon notification of any deviation from the approved plans and specifications, the

Customer shall immediately make modifications as directed by the City. No construction shall be commenced without final written approval of the plans and specifications by the City Engineer.

3. Customer will defend, indemnify, and hold the City harmless from any judgment, decree, order, demand, or claim (including costs or attorneys' fees), which in any way arises from Customer's negligence in performing this Agreement including the design and construction of the Facilities constructed by Customer, or from the act or omission of Customer or its agents. In addition, Customer shall, at all times, indemnify, defend and hold the City harmless from any and all loss, damage, cost or expense arising in any manner from Customer's obligations pursuant to this Agreement on account of the rights, privileges or conditions (contractual or otherwise), imposed by any federal, state or county agency. Nothing contained in this Agreement is, in any way, intended to be a waiver of the limitation placed upon the City's liability as set forth in Chapter 768, Florida Statutes. Additionally, the City does not waive sovereign immunity, and no claim or award against the City shall include attorney's fees, investigative costs or pre-judgment interest.

4. Ownership of such portions of the Facilities as are in the Public-Right-of-Way or across easements, shall be transferred to the City at such time as the City notifies the Customer that it is ready to accept such Facilities. Prior to such acceptance, all maintenance of the Facilities shall be by the Customer. At the time of acceptance by the City, the Customer shall furnish the City the following:

- a) An affidavit of Release of Lien for all materials, supplies and services.
- b) An executed Warranty Bond ("Bond") in the amount of one hundred ten percent (110%) of the value of the work constructed as estimated by the City, as protection to the City against losses and liabilities resulting from latent defects in materials or improper performances or work, which may appear or be discovered for a period of one (1) year from acceptance of the Facilities by the City. The Bond shall have as the surety only such companies as are authorized to write bonds of such character and amount under the laws of the State of Florida and with an agent in Miami-Dade County, Florida. Surety shall be rated by Best's Insurance Guide "A" or better. The Bond shall be in a form and amount to be approved by the City. The Bond shall expire upon the first-year anniversary of the City's acceptance of the Facilities.
- c) Certification by the Professional Engineer of Record that all Facilities were constructed in conformance with the approved documents and a certification as to the cost of the Facilities.

5. All costs relating to the Facilities including but not limited to labor, overhead, taxes, licenses application fees, easement acquisitions, lift stations, pumps pipes, materials, and any other direct or indirect costs related to installation of the Facilities shall be borne by the Customer and shall be fully paid by the Customer. All of City's costs in connection with the Facilities including but not limited to charges by the City's Engineer, the City's Attorneys' fees, inspections, maintenance, administrative expenses, and any other costs incurred by the City in connection with this matter shall be paid by the Customer. In addition to such costs, the Customer shall pay to the City a connection and/or tapping fee as shown in Exhibit "A". The City's connection fee and the City's costs shall be paid by the Customer within fifteen (15) days after being billed by the City. Any such billing by the City to the Customer shall be for items specified in the bill and may not necessarily cover all of the City's expenses, which shall be billed to the Customer separately. It is agreed that no reservation of capacity will be made by the City until all fees, set forth in Exhibit "A" have been paid. Payment of these fees shall in no way be construed as to relieve the Customer of its obligation to pay any further sums due in accordance with this Agreement that are charged subsequent to the completion of such connection.

6. In addition to all other charges set forth above, the Customer shall pay to the City a portion of all costs in connection with construction of the lines to which the Customer's Facilities are to be connected. This portion shall be indicated on Exhibit "A" as determined by the City. Payment shall be made by the Customer to the City within fifteen (15) days after billing by the City.

7. The Customer warrants and represents that it is either the owner of the Customer's Property described above or has the complete authority to act on behalf of the owner in executing this Agreement and that the terms hereof shall run with the land. It is acknowledged that this Agreement is for the purpose of providing a volume and rate of service to the Customer's Property described and that charges to be paid to the City for use of the City Facilities shall be charged to the ultimate user. Any increase in volume or rate of flow shall make this Agreement voidable on the part of the City. The City reserves the right to collect additional connection fees if the volume or rate of flow increases.

8. The design, installation and all future uses of the Facilities by the Customer or its successors or assigns shall be subject to the specific approval of the City of North Miami and where applicable, by all other governing authorities, including but not limited to Miami-Dade County, State of Florida, and the Miami-Dade Water & Sewer Authority, and there shall be no

subsequent modification or addition to the service to the Customer without the specific written consent of the City.

9. For the use of the City's system, the Customer shall pay a user rate established by the City Council of the City of North Miami, the billing to be issued by the City and paid by the Customer on a basis as the City customarily bills. The Customer shall, immediately upon demand pay to the City a non-interest bearing deposit as determined by the City. Upon failure of the Customer to immediately pay the periodic charges for service, the deposits shall immediately forfeit to the City. The City shall have the right to adjust its service rates to reflect current or future costs, and the Customer agrees to pay all such lawfully imposed rates, pursuant to City Code of Ordinances and applicable state laws.

10. Such parts of the system that are on the Customer's property shall at all times be maintained and repaired by the Customer; however, the City shall have the right to inspect such Facilities and the Customer, upon the City's written direction, shall make such repairs and maintenance as City directs.

11. If sewer service is covered by this Agreement, the Customer agrees that it shall not discharge or cause to be discharged into the sewer lines any of the following described waters or waste:

- a) Any surface drainage water or ground water infiltration.
- b) Any gasoline, benzene, naphtha, fuel oil or other inflammable or explosive liquid, solid or gas.
- c) Any noxious or malodorous gas or substances, which either singly or by interaction with other wastes, is capable of creating a public nuisance or hazard to life or preventing maintenance and repair of the lines or connecting lines and treatment facility.
- d) Any waters or waste containing toxic or poisonous substances in sufficient quantity to constitute a hazard to any structures and appurtenances of the lines and connecting lines and treatment facility, humans or animals or create any hazard or aesthetically undesirable conditions within or without lines and connecting lines and treatment facility. Such materials shall include, but shall not be limited to:
 - (1) Any cyanides in excess of two (2) milligrams per liter as (ON).
 - (2) Phenols in excess of three hundred (300) milligrams per liter by weight.

- (3) Hydrogen sulfide or sulfur dioxide in excess of ten (10) milligrams per liter by weight in sewage.
- (4) Iron in excess of twenty-five (25) mg. per liter.
- (5) Chromium in excess of ten (10) mg. per liter.
- (6) Copper in excess of ten (10) mg. per liter.
- (7) Zinc in excess of ten (10) mg. per liter.
- (8) Nickel in excess of ten (10) mg. per liter.
- (9) Biochemical oxygen demand in excess of two hundred (200) ppm.
- (10) Chlorine demand in excess of 50 ppm.

12. Whenever the term "parts per million by weight" is used, it means equivalent to "milligrams per liter," when reported in laboratory analysis results. The methods of analysis shall conform to Standard Methods for the Examination of Water and Waste Water, Eleventh Edition as published by the American Public Health Association. The quality limitations of this article shall apply to concentrations or other physical characteristics obtained by analysis of a composite sample of the waters or water collected for a 24-hour period, proportioned to flow. Periodic quality control tests shall be performed by chemists hired by the Water and Sewer Department of the City at the Customer's reasonable expense. The City may, from time to time, impose additional reasonable restrictions on the quality of discharge into the lines. The Customer further agrees to meet any and all regulations and conditions that may be required by future or existing contracts between the City and the State of Florida or Miami-Dade County, as well as meeting all requirements of Miami-Dade County Ordinance No.96-166. Customer agrees that in addition to any remedies provided for in the Ordinance No.96-166, the City may terminate any water and sewer service until the violation by the Customer is corrected to the satisfaction of the City.

13. The route of the lines from the Customer's property to the City's system shall be as determined by the City, and the Customer shall obtain, at its own expense, upon direction by the City any and all easements necessary which easements shall be in favor of the City of North Miami.

14. Any temporary cessation of the service by the City caused by an act of God, fire, strike, casualty, necessary maintenance work, breakdown of/or injuries to machinery, pumps or pipe lines, civil or military authority, insurrection, riot or any other unforeseeable circumstance, shall not constitute a breach of this Agreement on the part of the City, and the City shall not be liable to the Customer for any damage resulting from such cessation of service. The City shall not be responsible to the Customer for any backup, interruption of service, or any difficulty in the

discharge of the Customer's sewage into the City's sewage Facilities due to a cause beyond the City's control or otherwise.

15. Within the limits of F.S. Section 768.28, the Customer agrees to hold and save harmless the City for any litigation and/or damages including attorneys' fees and court costs resulting from the inclusion into the lines of the City's sewage Facilities of any substance in violation of the provisions of this Agreement, or resulting from any violation by the Customer of any of the provisions of this Agreement. In the event of any violation by the Customer of any of the provisions of this Agreement (other than the payment of money by the Customer to the City), the City shall give the Customer notice and the Customer shall rectify said violation within fourteen (14) days after such notice (if such violation is reasonably susceptible of correction within fourteen days, otherwise the Customer shall commence the correction within this period and complete the correction without delay). If the violation is of such emergency nature as reasonable warrants immediate corrective action, the City may, at its option, undertake and complete, concurrent with written notice to the Customer, such emergency action as the circumstances warrant, and any reasonable expense incurred by the City shall be paid by the Customer. In the event it becomes necessary for the City to enforce any provision of this Agreement by court action or otherwise, and the City prevails, the Customer will pay all of the City's costs, including attorney's fees, at all levels, including any appeals.

16. Where necessary, any approvals of this Agreement by any governmental agency shall be obtained by the Customer at Customer's expense, including where necessary, inclusion of the Customer's Property in the service area of the City. The City will cooperate with the Customer, at the Customer's expense, in obtaining any such approvals as are necessary.

17. All notice required shall be by certified mail, return receipt requested, to the Customer and to the City, addressed to : City Manager at 776 N.E. 125 Street, North Miami, Florida 33161 with a copy to the City Attorney at the same address.

18. This Agreement shall be binding upon the parties herein, their heirs, partners, executors, legal representatives, successors and assigns. Chapter 19 of the Code of Ordinances of the City of North Miami and Ordinance No. 811 as they apply to the Water and Sewer Enterprise of the City as presently existing and as may be amended in the future shall be deemed included as part of this Agreement. Any modification of this Agreement or any waiver or extension must be approved, in writing, by both parties.

19. The Customer agrees to dedicate to the City an easement, as to be determined by the City, so as to allow the City to enter the subject property and make such alterations, repairs, or other work to the Facilities, as the City shall deem necessary to achieve efficient Service. Any easement shall be dedicated to the City and so recorded at the Miami-Dade County Courthouse within ten (10) days of the signing of this Agreement, at Customer's expense.

20. If, at the time of execution, the property served pursuant to this Agreement is located within the unincorporated area of Miami-Dade County, Customer agrees that if the owner of the property attempts or allows such property now or in the future to be annexed or considered for annexation into any municipality, then in such event, the Customer grants to the City of North Miami, the right of first refusal to be the sole municipality to which the land will be annexed.

21. This Agreement shall be recorded by the Customer at its expense in the Public Records of Miami-Dade County in order to give notice to any successor in interest of the provisions of this Agreement. This Agreement shall run with the land of Customer as described in Exhibit "A".


[The remainder of this page is intentionally left blank.]

IN WITNESS WHEREOF, the parties have executed this Agreement by their respective proper officers duly authorized the day and year first written above.

CORPORATE ACKNOWLEDGMENT

ATTEST:

Corporate Secretary or Witness:

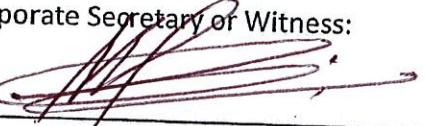By: 

Print Name: MAGGIE Dumay
Date: 11/07/2023

Tabernacle of Glory:

"Customer": 


By: 

Print Name: CAINGIFI GUERRIER
Date: 11/07/23

STATE OF FLORIDA)

COUNTY OF MIAMI-DADE)

The foregoing instrument was acknowledged before me this 7 day of Nov., 2023,
by CAINGIFI GUERRIER, who is personally known to me, or who has
produced _____ as identification.

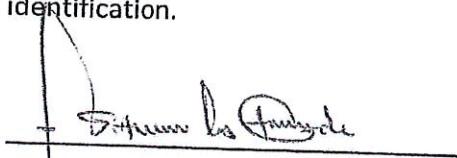

Notary Signature

Jean Claude Fortilus
Print Name

Notary Public – State of Florida

Commission No: HH178992

My Commission Expires: 09-25-2025

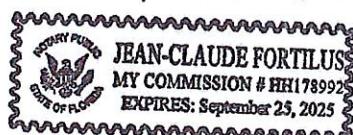

CITY ACKNOWLEDGMENT

ATTEST:

City of North Miami, a Florida municipal Corporation: "City"


By: 

Vanessa Joseph, Esq.
City Clerk

By: 

Rasha Cameau, MBA, PRA-RP
City Manager

APPROVED AS TO FORM AND
LEGAL SUFFICIENCY:

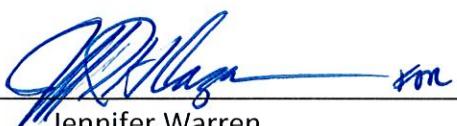
By: 

Jennifer Warren
Deputy City Attorney

STATE OF FLORIDA)

COUNTY OF MIAMI-DADE)

The foregoing instrument was acknowledged before me this 11th day of November, 2023,
by Rasha Cameau, who is personally known to me or who has
produced _____ as identification.

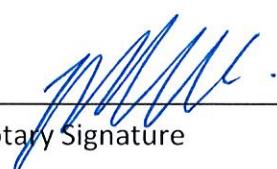

Notary Signature




Print Name

Notary Public – State of Florida

Commission No: HH 042 945

My Commission Expires: 9/26/2024

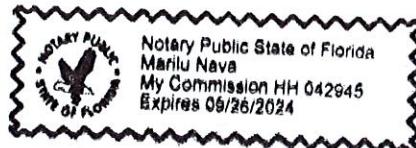

ENGINEER ACKNOWLEDGMENT

BY: Chuks

Chuks U. Okereke

City Engineer
City of North Miami

STATE OF FLORIDA)

COUNTY OF MIAMI-DADE)

The foregoing instrument was acknowledged before me this 16th day of November, 2023,
by Chuks U. Okereke, who is personally known to me or who has
produced _____ as identification.

Frantzy Daniel
Notary Signature
Frantzy Daniel
Print Name



Notary Public – State of Florida
Commission No: HH248415
My Commission Expires: 4/1/2026


EXHIBIT "A" (1 of 4)
TABERNACLE OF GLORY
350 NW 161ST STREET NORTH MIAMI BEACH, FL 33160
MIAMI-DADE COUNTY
SEWER AS BUILT (PRIVATE)

AS-BUILT LEGEND:

- CLEAROUT
- SEWER MAIN
- PROPERTY LINE
- RIGHT OF WAY LINE
- CENTER LINE
- FLOW DIRECTION
- GRAVITY MAIN / FORCE MAIN - EXISTING
- SEWER WYE
- HORIZONTAL BEND
- BEND VERTICAL
- MANHOLE - EXISTING
- MANHOLE - NEW
- GATE VALVE / PLUG VALVE - EXISTING
- GATE VALVE / PLUG VALVE - NEW
- TAPPING SLEEVE & VALVE
- CHECK VALVE BURIED
- CHECK VALVE IN MANHOLE
- PUMP STATION
- GENERATOR HOUSING
- GENERATOR
- GRAVITY MAIN / FORCE MAIN - ABANDONED OR REMOVED

ABBREVIATIONS:


- M.H. MANHOLE
- W.M. WATER MAIN
- SEW. SEWER
- INVERT
- SAN. SANITARY
- C.O. CLEAROUT
- F.M. FORCE MAIN
- S.P. SAMPLE POINT
- A.C. ASBESTOS CEMENT PIPE
- V.C.P. VITRIFIED CLAY PIPE
- C.I.P. CAST IRON PIPE
- H.D.P.E. HIGH DENSITY POLYETHYLENE
- R.C.P. REINFORCED CONCRETE PIPE
- P.V.C. POLY VINYL CHLORIDE
- D.I.P. DUCTILE IRON PIPE
- T.O.P. TOP OF PIPE
- BOT. BOTTOM
- P.D. PLAT BOOK
- P.G. PAGE
- R.W. RIGHT OF WAY
- F.S. FLORIDA STATE
- O.R.B. OFFICIAL RECORDS BOOK
- N.G.V.D. NATIONAL GEODETIC VERTICAL DATUM
- N.A.V.D. NORTH AMERICAN VERTICAL DATUM
- C.O.M. CITY OF MIAMI DATUM
- B. BASE LINE
- E. EQUATORIAL LINE
- C. CENTER LINE
- M. MOUNTAIN LINE
- F.F. FINISH FLOOR
- L.F. LINEAR FEET
- L.T. LEFT TURN
- L.T. LATENT
- R.T. RIGHT TURN
- B.E. BUFFER EASEMENT
- G.V. GATE VALVE
- F.H. FIRE HYDRANT
- D.D.C.V. DOUBLE DETECTOR CHECK VALVE
- F.D.C. FIRE DEPARTMENT CONNECTION
- F.V. FIRE VALVE
- F.V.O. FLUSHING VALVE OUTLET
- R.P.Z.P. REDUCER / PRESSURE ZONE BACKFLOW PREVENTER
- CORP. STOP. CORPORATION STOP
- P.O.B. POINT OF BEGINNING
- P.O.C. POINT OF COMMENCEMENT
- P.O.T. POINT OF TRANSITION
- S.D. STORM DRAINAGE
- W.S. WATER SERVICE
- F.L. FIRE LINE
- C.H.M. CITY NORTH MIAMI
- STA. 0-00 Station Equation
- STA. 0-00 Station Equation

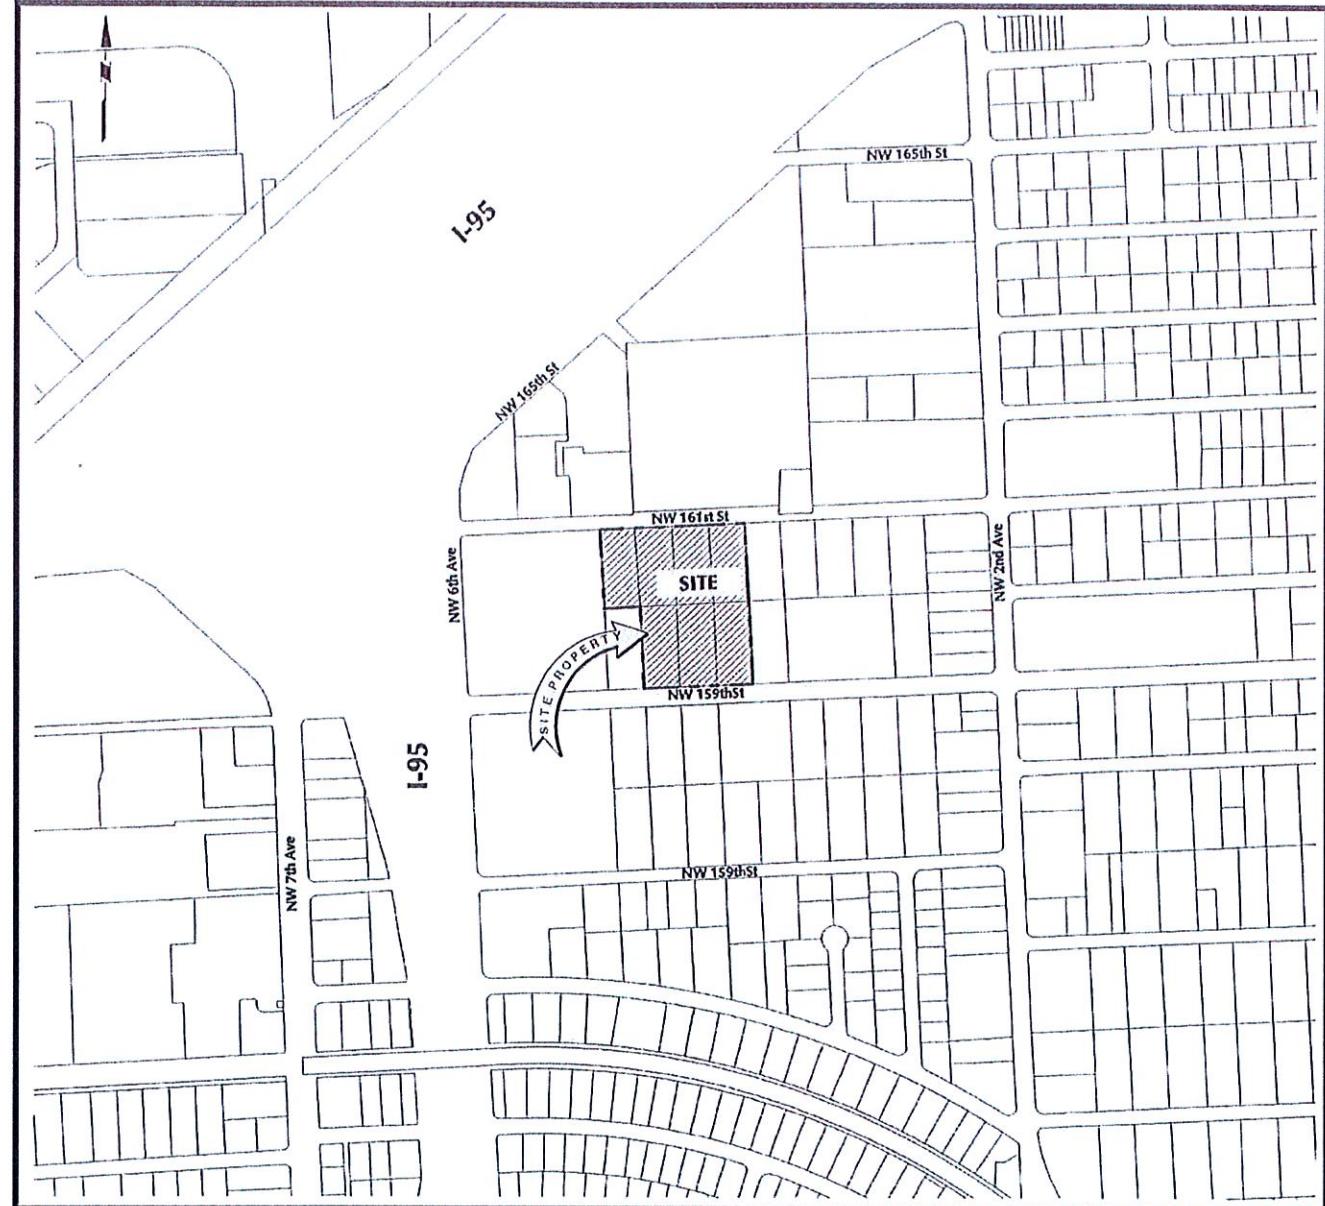

SECTION 13, TOWNSHIP 52 SOUTH, RANGE 41 EAST

LOCATION MAP

SCALE: 1"=300'

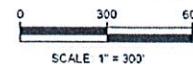

INDEX OF SHEET

- SHEET S-1.....SEWER COVER SHEET
- SHEET S-2.....SEWER PLAN VIEW SHEET
- SHEET S-3.....SEWER & FORCE MAIN PROFILE
- SHEET S-4.....MOPS PUMP STATION SCHEDULE

NOT VALID WITHOUT SIGNATURE AND ORIGINAL RAISED SEAL OF A LICENSED PROFESSIONAL SURVEYOR AND MAPPER

LEGAL DESCRIPTION

PARCEL 1: LOTS 410, 427, 428, AND 429, OF BISCAYNE GARDENS SECTIONS B, ACCORDING TO THE PLAT THEREOF AS RECORDED IN PLAT BOOK 40, PAGE 49 OF THE PUBLIC RECORDS OF MIAMI-DADE, FLORIDA

PARCEL 2: THE EAST $\frac{1}{2}$ OF THE WEST $\frac{1}{2}$ OF THE NORTH $\frac{1}{2}$ OF THE SOUTHWEST $\frac{1}{2}$ OF THE NORTHWEST $\frac{1}{2}$ LESS THE NORTH 25 FEET, OF SECTION 13, TOWNSHIP 52 SOUTH, RANGE 41 EAST, LESS THE NORTHERLY 25 FEET THEREOF, LYING AND SITUATE IN MIAMI-DADE COUNTY, FLORIDA

PARCEL 3: THE EAST $\frac{1}{2}$ OF THE WEST $\frac{1}{2}$ OF THE NORTH $\frac{1}{2}$ OF THE SOUTHWEST $\frac{1}{2}$ OF THE NORTHWEST $\frac{1}{2}$ OF SECTION 13, TOWNSHIP 52 SOUTH, RANGE 41 EAST, LESS THE NORTHERLY 25 FEET THEREOF, LYING AND SITUATE IN MIAMI-DADE COUNTY, FLORIDA

PARCEL 4: THE WEST $\frac{1}{2}$ OF THE NORTH $\frac{1}{2}$ OF THE SOUTHWEST $\frac{1}{2}$ OF THE SOUTHEAST $\frac{1}{2}$ OF THE NORTHWEST $\frac{1}{2}$ OF SECTION 13, TOWNSHIP 52 SOUTH, RANGE 41 EAST, LESS THE NORTH 25 FEET THEREOF, KNOWN AS TRACT 388 OF SECTION 8 OF THE SUBDIVISION OF BISCAYNE GARDENS, UNRECORDED PLAT.

SURVEYOR'S NOTES:

- 1.) THIS IS NOT A BOUNDARY SURVEY.
- 2.) REPRODUCTIONS OF THIS DRAWING ARE NOT VALID UNLESS EMBOSSED WITH THE OFFICIAL SEAL OF THE SURVEYOR.
- 3.) TYPE OF SURVEY: SEWER MAIN AS-BUILT
- 4.) TRANSAMERICA, ESM, INC. CARRIES PROFESSIONAL LIABILITY INSURANCE
- 5.) ELEVATIONS SHOWN HEREON ARE BASED ON NATIONAL GEODETIC VERTICAL DATUM OF 1929 (N.G.V.D. 29)
- 6.) THE HORIZONTAL POSITIONAL ACCURACY OF WELL DEFINED IMPROVEMENTS ON THIS SURVEY IS ± 0.2 . THE VERTICAL ACCURACY OF ELEVATIONS OF WELL DEFINED IMPROVEMENTS ON THIS SURVEY IS ± 0.4 .
- 7.) ALL MEASUREMENTS ARE IN ACCORDANCE WITH THE UNITED STATES STANDARD U.S. FOOT.
- 8.) BENCH MARK USED: MIAMI-DADE BENCH MARK NAME N-732, Locator 2121 S, Elevation 6.34' (N.G.V.D. 29)

LOCATION: NW 159 STREET - 25 South of Center Line
 NW 2nd AVENUE - 100' West of Center Line
 DESCRIPTION: PJK Nail and Brass washer in concrete Slab of traffic control box

9.) THE HORIZONTAL CONTROL ELEMENT OF THIS AS-BUILT SURVEY WAS DERIVED FROM THE NORTH AMERICAN DATUM E3-1993 AS IMPLEMENTED BY MIAMI-DADE WATER & SEWER DEPARTMENT GPS/GIS PROJECT MASTER CONTROL.

STATE PLANE COORDINATE SYSTEM

STATE PLANE ZONE (FLORIDA EAST 0591)

HORIZONTAL DATUM: NAD 83 (1993)

Points (Northing and Easting) as depicted on the survey are based on the North American Datum (NAD) 1983-1993 adjustment, global positioning system (G.P.S.) measurements were conducted in the field to acquire said coordinates values, based on the following horizontal control stations:

- ① ESTABLISHING AGENCY: MIAMI-DADE COUNTY WATER & SEWER DEPT. GPS/GIS PROJECT.
 STATE/COUNTY: FLORIDA MIAMI-DADE COUNTY
 STATION IDENTIFICATION: 12
 STATION NAME: KING
 DATUM: NAD 83 (1993)
 LATITUDE: 25° 49' 59.920703" NORTH
 LONGITUDE: 80° 11' 46.655976" WEST
 NORTHING: 581252.738 US FEET
 EASTING: 920281.059 US FEET
 STATION DESCRIPTION: The station is located northeast of the intersection of NE 1st Ter. and NE 2nd Av. and is just west of a sidewalk, the mark is a concrete monument with a METRO-DADE GPS CONTROL PT. brass disk and is stamped "KNG".
- ② ESTABLISHING AGENCY: MIAMI-DADE COUNTY WATER & SEWER DEPT. GPS/GIS PROJECT.
 STATE/COUNTY: FLORIDA MIAMI-DADE COUNTY
 LOCATION: 225A
 STATION NAME: DC46A
 DATUM: NAD 83 (1993)
 LATITUDE: 25° 54' 15.153220" NORTH
 LONGITUDE: 80° 10' 59.328525" WEST
 NORTHING: 571711.9002 US FEET
 EASTING: 924726.4554 US FEET
 STATION DESCRIPTION: Station mark is a brass disk, set in concrete sidewalk on the NE quadrant of the intersection of NE 8 Avenue and NE 14th Street mark is located 26.1 feet North of the Centerline of NE 8 Avenue and 61 feet North of the Centerline of NE 14th Avenue. Station mark is a brass disk stamped METRO-DADE GPS PT DC46-A.

10.) FIELD DATE: September 25, 2020

SURVEYOR'S CERTIFICATE:

HEREBY CERTIFY THAT THE AS-BUILT SURVEY MAP IS TRUE AND CORRECT AND WAS MADE UNDER MY DIRECT SUPERVISION AND THAT IT MEETS THE STANDARDS OF PRACTICE SET FORTH BY THE FLORIDA BOARD OF PROFESSIONAL SURVEYORS AND MAPPERS IN CHAPTER 5J-17.051 THRU 5J-17.052 OF THE FLORIDA ADMINISTRATIVE CODE, PURSUANT TO CHAPTER 472.027, FLORIDA STATUTE, SUBJECT TO NOTES AND NOTATIONS SHOWN HEREON.



Julio Quintana P.S.M.
 PROFESSIONAL SURVEYOR & MAPPER
 STATE OF FLORIDA REG. No. E214
 7-05-22
 TABERNACLE OF GLORY

Job No.: 18-012
 Date: 9-25-2020
 Drawn by: J.A. Quintana
 Approved by: J.A. Quintana
 Scale: 1"=300'
 Cst. Fee: 15-012
 TABERNACLE OF GLORY
 Sheet Number: S-1
 C:\Users\jquintana\Downloads\18-012\18-012.dwg
 SHEET 1 OF 4

TABERNACLE OF GLORY

TRANSAMERICA, ESM INC. •
 PROFESSIONAL LAND SURVEYOR AND MAPPER
 7971 NW 10th TER, MIAMI, FL 33151
 OFFICE: 305.262.6000
 MOBILE: 786.482.4076
 E-MAIL: JQUINTANA@TRANSAMERICASURVEY.COM
 Quintana.J@Transamericasurvey.com

S-1
 SHEET 1 OF 4

TABERNACLE OF GLORY
350 NW 161ST STREET NORTH MIAMI BEACH, FL 33160
SEWER AS BUILT (PRIVATE)
EXHIBIT "A" (2 of 4)

NORTH

THE TABERNACLE OF GLORY SEVER AS BUILT (PRIVATE)

161ST STREET NORTH MIAMI BEACH, FL 33160



100


A circular professional surveyor's license seal. The outer ring contains the text "PROFESSIONAL SURVEYOR" at the top and "FLORIDA" at the bottom. The center of the seal contains "JULIO A. QUINTANA" at the top, "8214" in the middle, and "FLORIDA" at the bottom. Below "FLORIDA" is the text "Professional Surveyor and Mapper". The entire seal is enclosed in a circular border.


7-05-22
JULIO QUINTANA P.S.M.
PROFESSIONAL SURVEYOR & MAPPER,
STATE OF FLORIDA REG. No. 6214

Job No.: 1B-012
 Date: 9-25-2020
 Drawn by: M. Harris
 Specified by: J.A. Quintana
 Scale: 1" = 30'
 Cast #: 12-012
 TABERNACLE OF GLOR
 Sheet Numb
S-2
 SHEET 2 OF 4

TABERNACLE OF GLORY
350 NW 161ST STREET NORTH MIAMI BEACH, FL 33160
SEWER AS BUILT (PRIVATE)

EXHIBIT "A" (3 of 4)

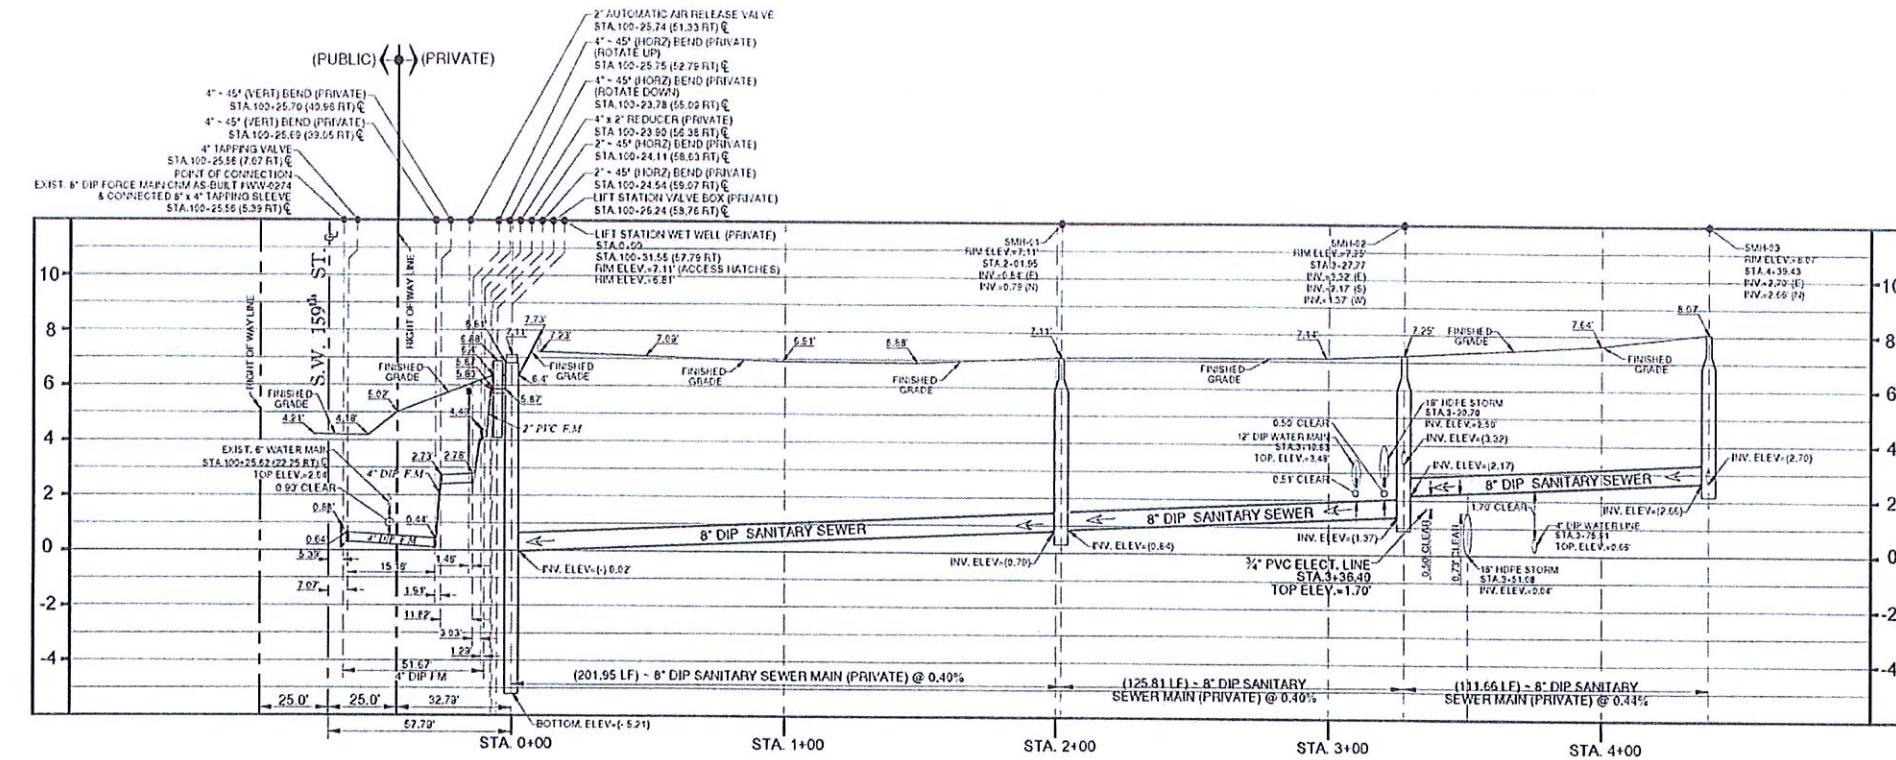

**TABERNACLE OF GLORY
SEWER AS BUILT (PRIVATE)**

350 NW 161ST STREET NORTH MIAMI BEACH, FL 33160

TRANSAMERICA ESM INC.[®]
PROFESSIONAL LAND SURVEYOR AND MAPPER
1100 N.W. 18TH STREET, MIAMI, FLORIDA 33105
OFFICE: (305) 825-6800 FAX: (305) 442-7750
MOBILE: (305) 467-1000 E-MAIL: TRANSAM@COMCAST.NET
TRANSAMSurvey.com Outlines.com

Job No.: 18-012
 Date: 9-25-2020
 Drawn by: M. Bains
 Approved by: J.A. Quintana
 Scale: 1"=30'-0" 1"=3'V
 Cadfile: 18-012
 SHEET 3 OF 4
 SHEET 3 OF 4
 SHEET 3 OF 4

NOT VALID WITHOUT SIGNATURE AND ORIGINAL RAISED SEAL OF A LICENSED PROFESSIONAL SURVEYOR AND MAP

MOPS PRIVATE SERIES

MANUFACTURED ODORLESS PUMP STATION
ATLANTIC ENVIRONMENTAL SYSTEMS, INC.
LAKE WORTH, FL 33461
PH: (561) 547-8080 FAX: (561) 547-3999
©2000

THIS DRAWING AND THE DESIGN CONTAINED HEREIN IS PROPRIETARY
AND TRADE SECRET OF ATLANTIC ENVIRONMENTAL
SYSTEMS, INC. THIS DRAWING AND DESIGN SHOULD BE USED ONLY FOR
THE PURPOSE FOR WHICH IT IS INTENDED, AND ONLY WITH WRITTEN
AUTHORIZATION FROM ATLANTIC ENVIRONMENTAL SYSTEMS, INC. ANY
REPRODUCTION, IN WHOLE OR IN PART, WITHOUT PERMISSION FROM
ATLANTIC ENVIRONMENTAL SYSTEMS, INC. VIOLATES ATLANTIC
ENVIRONMENTAL SYSTEMS' COPYRIGHTS.

DATE 08/02/17
REVISION 01 02 03 10/24/17
10/28/17
10/24/17

MOPS PUMP STATION SCHEDULE

MOPS SERIES	ITEM DESCRIPTION
INITIAL DESIGN FLOW (G.P.M.)	22 100 YEAR FLOOD ELEVATION 7.30'
INITIAL DESIGN HEAD (T.D.H.)	79' 25 YEAR FLOOD ELEVATION 6.80'
SECONDARY DESIGN FLOW (G.P.M.)	41 A GRADE ELEVATION 6.72' 6.5'
SECONDARY DESIGN HEAD (T.D.H.)	21' B TOP ELEVATION OF WET WELL 6.72' 7.11'
RATED PERFORMANCE SPEED	3450 RPM C BOTTOM ELEVATION OF WET WELL -5.26' (-5.21')
RATED MOTOR HORSEPOWER	3.0 D ALL PUMPS OFF ELEVATION -3.00'
SUBmersible PUMp TYPE (P-1,P-2)	GRINDER E LEAD PUMP ON ELEVATION -2.00'
PUMP MODEL NUMBER	MOPS F LAG PUMP ON ELEVATION -1.50'
SERVICE ENTRANCE VOLTAGE	230 G HIGH ALARM ELEVATION -1.00'
SERVICE ENTRANCE PHASE	3 H INSIDE DIAMETER OF WET WELL 48"
CONTROL CENTER FULL LOAD AMPS	29 I OUTSIDE DIAMETER OF ANTI-FLOATATION RING 84"
HEMA SR PAINTED STEEL DISCONNECT SWITCH, RATED AMPS	30 J MINIMUM CUBIC FEET OF CONCRETE BALLAST (CU YDS) 000/(0)
WET WELL SCOURER SYSTEM	H/A K INVERT PIPE DIAMETER 8"
REMOTE STATION MONITOR (TELEMETRY)	W/SA L FORCE MAIN DIAMETER 2 1/4"
ON-SITE GENERATOR SYSTEM	N/A M PRIMARY INVERT ELEVATION -0.63' (-0.02')
	N INTERNAL PIPE DIAMETER 2"

MOPS EQUIPMENT IDENTIFICATION	QTY.	MODEL DESIGNATION
MOPS PUMP STATION	1	B22-48144-C-3.0
MOPS VALVE BOX ASSEMBLY (VBA)	1	VBA-22
MOPS ODOR/GAS SCRUBBER (OGS)	1	OGS-B
MOPS R.P.Z. ASSEMBLY	1	75
MOPS CONTROL CENTER	1	PSC-222-3.0
MOPS DISCONNECT SWITCH	1	FDS-30-3-2-PS
MOPS CONTROL CENTER MOUNTING ASSEMBLY	1	CCMA-32AL
MOPS WET WELL SCOURER SYSTEM	0	N/A
MOPS REMOTE STATION MONITOR	1	PROVIDED WITH SERVICE AGREEMENT
1st YEAR SERVICE/MAINTENANCE CONTRACT	1	LEVEL 1 WITH REMOTE MONITOR
MOPS ON-SITE GENERATOR SYSTEM	0	N/A
MOPS FIELD SERVICE WORK	1	CONTROL INSTALLATION & START-UP

MOPS PUMP STATION COMPLIANCE NOTES

THIS PUMP STATION DESIGN COMPLIES WITH THE FOLLOWING REQUIRED STANDARDS:

- STATE OF FLORIDA ENVIRONMENTAL PROTECTION STANDARDS
- FLORIDA ADMINISTRATIVE CODE (F.A.C.) 62-640.400 - COLLECTION AND TRANSMISSION SYSTEMS
- NATIONAL ELECTRIC CODE (NEC) CLASS 1, DIVISION 1, GROUP D - HAZARDOUS LOCATIONS
- UNDERWRITER'S LABORATORIES (U.L.) 508A-MOTOR CONTROL CENTERS AND U.L. 698A-INSTRINSICALLY SAFE CONTROL CENTERS
- RECOMMENDED STANDARDS FOR WASTEWATER FACILITIES (1997 EDITION).

- PUMPS ARE RATED BY FACTORY MUTUAL FOR CLASS 1, DIVISION 1, GROUP D ATMOSPHERES AS REQUIRED BY NEC.
- THE CONTROL CENTER INCORPORATES INTRINSICALLY SAFE RELAYS AND IS LISTED TO UL 698A INTRINSICALLY SAFE FOR CLASS 1, DIVISION 1 ATMOSPHERES.
- THE CONDUIT PROVIDED, ALONG WITH CONDUIT GAS-SEAL-OFFS, ARE RATED FOR CLASS 1, DIVISION 1 LOCATIONS.
- THE WASTEWATER PUMPS AND THE CONTROL CENTER INCORPORATE A MECHANICAL SEAL FAILURE DETECTION AND NOTIFICATION SYSTEM.
- THE CONTROL CENTER INCLUDES EITHER A REMOTE TELEMETRY UNIT (RTU) OR A SELF-CHARGING, BACK-UP ALARM SYSTEM TO OPERATE ON POWER FAILURE.
- THE PUMP STATION INCORPORATES AN ODORLESS DESIGN WITH A SCRUBBER SYSTEM TO CONTROL TOXIC GASES AND ODORS FOR COMPLIANCE TO F.A.C. 62-604.400.
- THE BOTTOM OF THE TOP RIM ELEVATION OF PUMP STATION MUST BE LOCATED AT A HIGHER ELEVATION THAN THE 25 YEAR FLOOD ELEVATION. THE LISTED 25 YEAR FLOOD ELEVATION PROVIDED BY SITE CIVIL ENGINEER.
- THE BOTTOM ELEVATION OF THE MOPS CONTROL CENTER MUST BE LOCATED AT A HIGHER ELEVATION THAN THE 100 YEAR FLOOD ELEVATION. THE LISTED 100 YEAR FLOOD ELEVATION PROVIDED BY THE SITE CIVIL ENGINEER.

MOPS ENGINEERING NOTES

- THE HORSEPOWER SHOWN ON THE SCHEDULE IS A MINIMUM HORSEPOWER REQUIREMENT BASED ON THE STATION'S DESIGN CRITERIA AND THE REQUIRE TORQUE. (LOWER RATED HORSEPOWER EQUIPMENT WILL NOT BE ACCEPTABLE.)
- THESE ITEMS ARE NOT SUPPLIED BY A.E.S. WITH THE MOPS STATION.
- INVERT ELEVATIONS BASED ON INSIDE BOTTOM OF PIPE.
- THE MOPS CONTROL ASSEMBLY CONSISTS OF THE FOLLOWING: CONTROL CENTER DISCONNECT SWITCH, MOUNTING ASSEMBLY, ELECTRICAL CONDUITS, AND SEAL-OFF. THESE ITEMS MUST BE SUPPLIED AND INSTALLED BY THE MOPS PUMP STATION MANUFACTURER TO VALIDATE MOPS WARRANTY PROGRAM.

THE MOPS WASTEWATER PUMP STATION DESIGN AND EQUIPMENT SHOWN ON THIS DRAWING HAS BEEN REVIEWED, PERMITTED, AND CERTIFIED AS COMPLYING WITH ALL THE STATE OF FLORIDA D.E.P. AND LOCAL REQUIREMENTS. ANY SUBSTITUTION FROM THIS DESIGN MAY REQUIRE NEW PERMITS, APPLICATION FEES, AND ENGINEERING SERVICES FOR RE-CERTIFICATION AND DESIGN REVIEW.

P.E. CERTIFICATION

Bonnie S. McLeod, P.E. * 70797
V.P. of Engineering *
Atlantic Environmental Systems, Inc. A # 26398
2244 4th Ave. North, Lake Worth, Florida 33461
Ph: 561-547-8080 / FAX: 561-547-3999

PRIVATE PUMP STATION

1039
A.E.S. Project No.: 10/11/16
Prepared For: Date:

Page No.:

LS-1

Exhibit C (4 of 4)

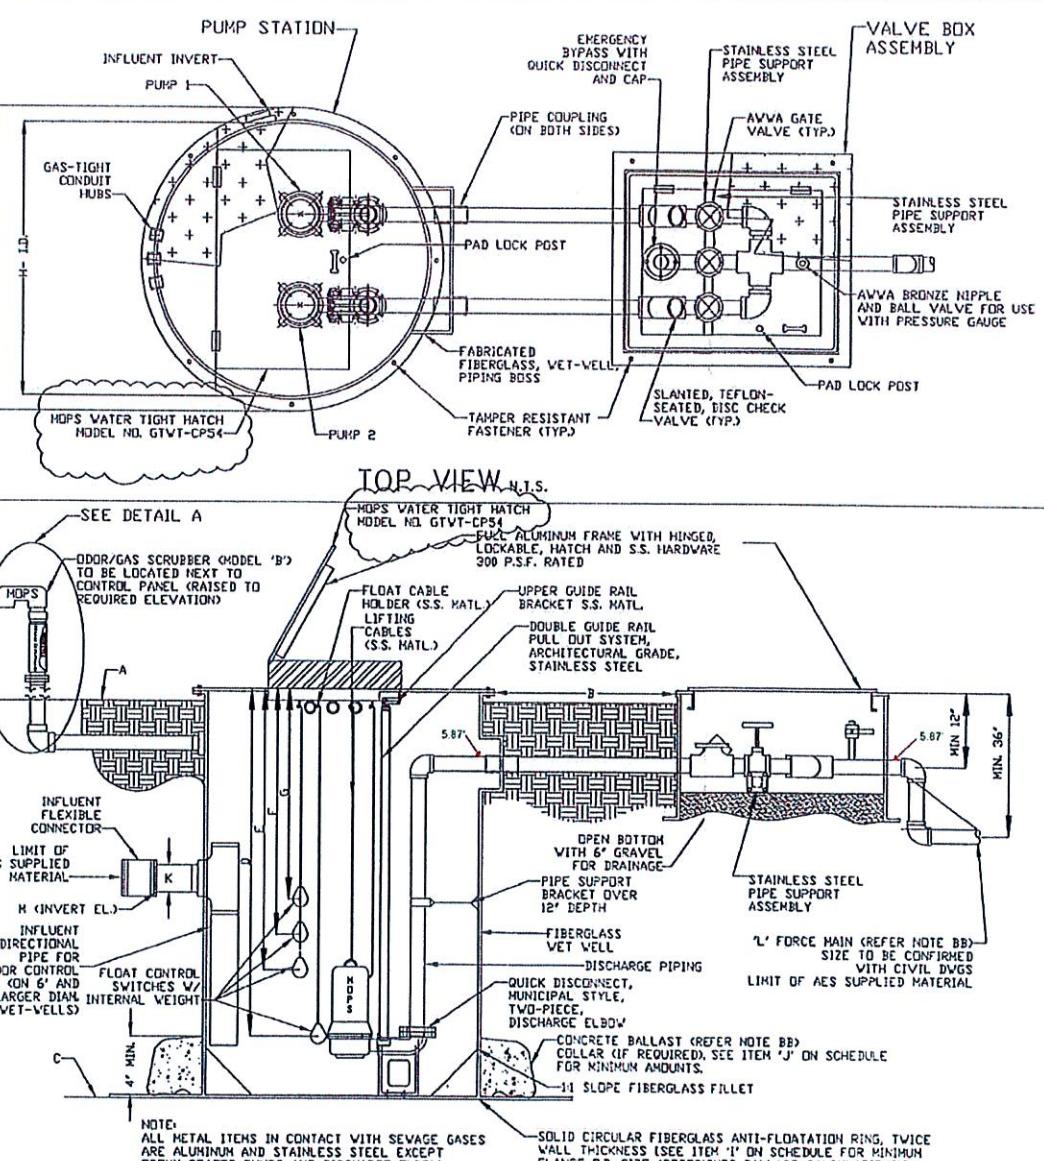
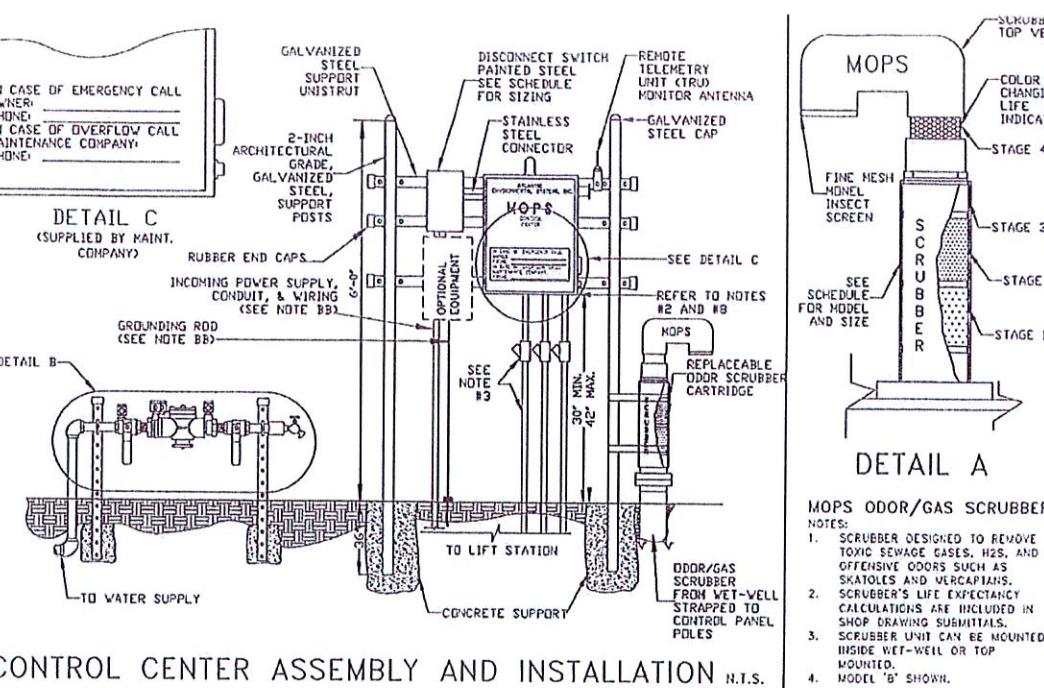
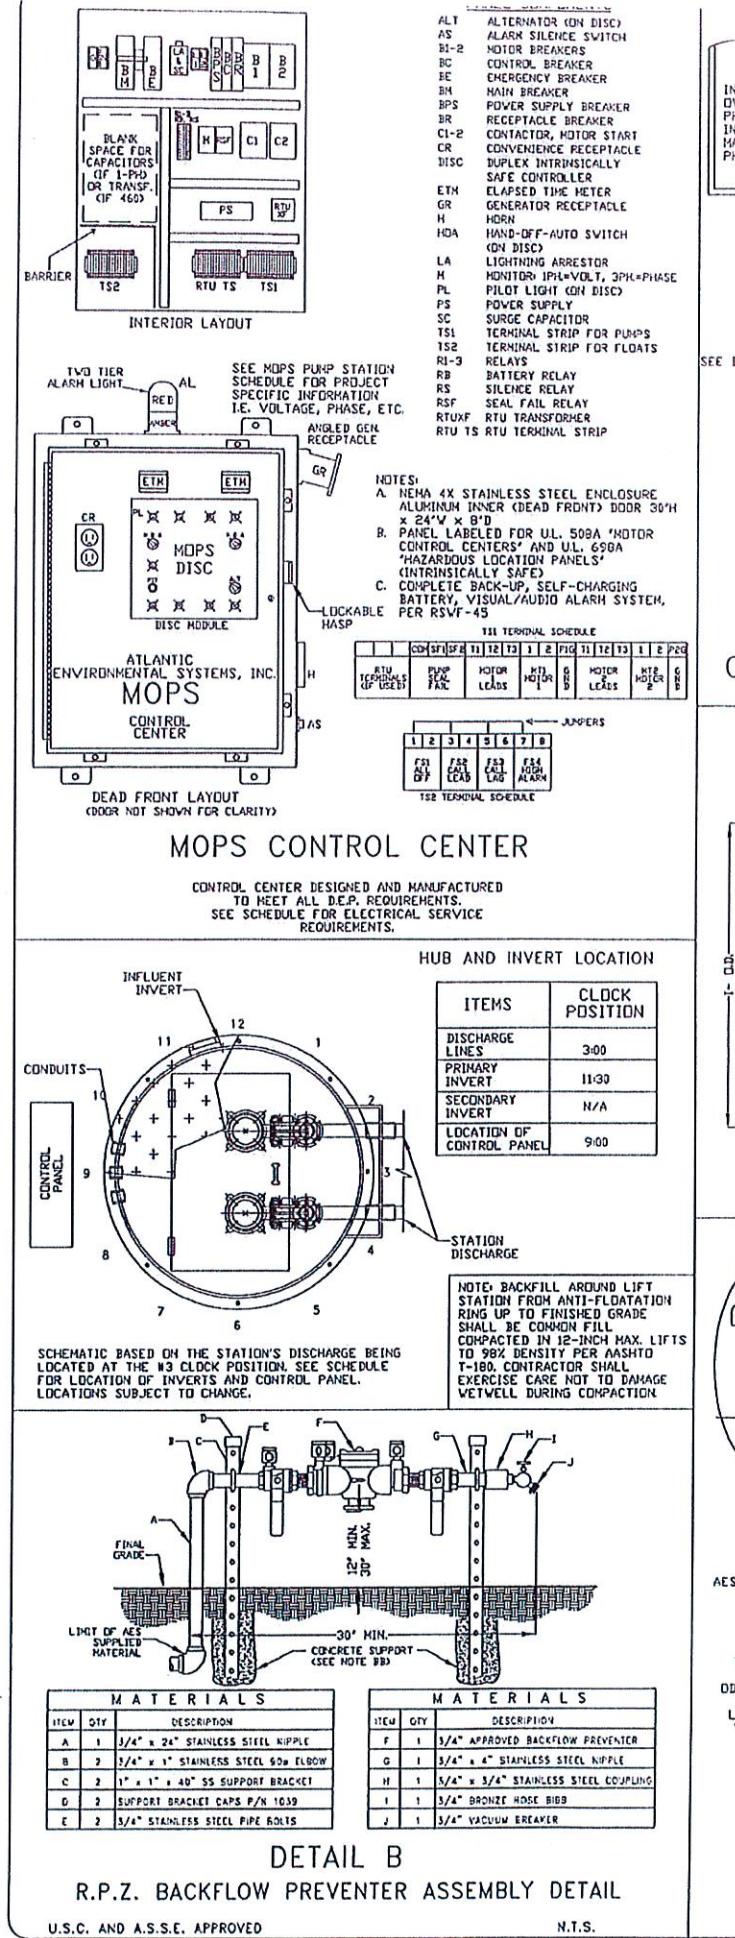




EXHIBIT "B" – Legal Description

1. Project Name: Tabernacle of Glory
2. Owner's Name and Mailing Address: Gregory Toussaint – 990 NE 125TH Street, Suite 200 Miami, FL 33161
3. Property address: 390 NW 161st Street North Miami Beach, FL 33160
4. Property Folio No. 30-2113-000-0180
5. Legal Description of the property:

PARCEL 1:

LOTS 410, 427, 428 AND 429, OF BISCAYNE GARDENS SECTIONS B, ACCORDING TO THE PLAT THEREOF AS RECORDED IN PLAT BOOK 40, PAGE 49 OF THE PUBLIC RECORDS OF MIAMI-DADE, FLORIDA.

PARCEL 2:

THE EAST 1/3 OF THE WEST 3/5 OF THE NORTH 1/2 OF THE SOUTHWEST 1/4 OF THE SOUTHEAST 1/4 OF THE NORTHWEST 1/4 LESS THE NORTH 25 FEET, OF SECTION 13, TOWNSHIP 52 South, RANGE 41 EAST, LYING AND SITUATE IN MIAMI-DADE COUNTY, FLORIDA

PARCEL 3:

THE EAST 1/2 OF THE WEST 2/5 OF THE NORTH 1/2 OF THE SOUTHWEST 1/4 OF THE SE 1/4 OF THE NORTHWEST 1/4, OF SECTION 13, TOWNSHIP 52 SOUTH, RANGE 41 EAST, LESS THE NORTHERLY 25 FEET THEREOF, LYING AND SITUATE IN MIAMI-DADE COUNTY, FLORIDA

PARCEL 4:

THE WEST 1/5 OF THE NORTH 1/2 OF THE SOUTHWEST 1/4 OF THE SOUTHEAST 1/4 OF THE NORTHWEST 1/4 OF SECTION 13, TOWNSHIP 52 SOUTH, RANGE 41 EAST, LESS THE NORTH 25 FEET THEREOF, KNOWN AS TRACT 386 OF SECTION "B" OF THE SUBDIVISION OF BISCAYNE GARDENS, UNRECORDED PLAT.

EXHIBIT "C"

**EXHIBIT "C" to the AGREEMENT between the CITY OF NORTH MIAMI and
TABERNACLE OF GLORY, INC.**

Date: 10/31/2023

**AGREEMENT for:
390 NW 161st Street,
Miami, FL 33160**

Tax Folio #: 30-2113-000-0180

City File: SC-

Legal Description of Customer's property:

See Exhibit "B"

Point of Connection to the City's sewer system:

**Sanitary Sewer Force Main
(FM) at NW 161st to Existing 8"
FM.**

ALLOCATED VOLUME:

**Proposed Sewer Flow - Two (2) Story Worship (Church with associated
improvements)** = **5940 gpd**

Existing sewer system is a Vacant Lot = **0 gpd**

Net Difference = **5940 gpd**

FEES TO BE PAID TO THE CITY:

Sewer Impact Fee (5940 gpd x \$2.79/gpd) = **\$ 16,572.60**

Sewer Administration Fee = **\$ 79.53**

Total Amount to be paid to City = **\$ 16,652.13**

EXHIBIT "C"

The installation of the following facilities shall be accomplished by the Customer and deeded to the City:


1. 16 LF of 4" C-900 FM

Other conditions:

As per Agreement

APPROVAL:

By: City Manager:

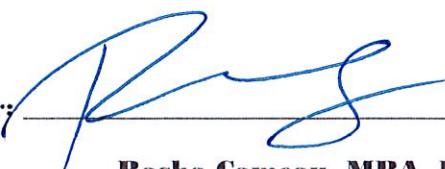

Date: 11/21/23

Rasha Cameau, MBA, FRA-RP

By: City Engineer:



Date: 11/03/2023

Chuks U. Okereke



Public Works Division
Water & Sewer Department
Utility Operations Center

1815 N.E. 150 Street • North Miami, FL 33181 • T: (305) 895-9838 • F: (305) 787-1008

EXHIBIT "B" – Legal Description

1. Project Name: Tabernacle of Glory
2. Owner's Name and Mailing Address: Gregory Toussaint – 990 NE 125TH Street, Suite 200 Miami, FL 33161
3. Property address: 390 NW 161st Street North Miami Beach, FL 33160
4. Property Folio No. 30-2113-000-0180
5. Legal Description of the property:

PARCEL 1:

LOTS 410, 427, 428 AND 429, OF BISCAYNE GARDENS SECTIONS B, ACCORDING TO THE PLAT THEREOF AS RECORDED IN PLAT BOOK 40, PAGE 49 OF THE PUBLIC RECORDS OF MIAMI-DADE, FLORIDA.

PARCEL 2:

THE EAST 1/3 OF THE WEST 3/5 OF THE NORTH 1/2 OF THE SOUTHWEST 1/4 OF THE SOUTHEAST 1/4 OF THE NORTHWEST 1/4 LESS THE NORTH 25 FEET, OF SECTION 13, TOWNSHIP 52 South, RANGE 41 EAST, LYING AND SITUATE IN MIAMI-DADE COUNTY, FLORIDA

PARCEL 3:

The EAST 1/2 OF THE WEST 2/5 OF THE NORTH 1/2 OF THE SOUTHWEST 1/4 OF THE SE 1/4 OF THE NORTHWEST 1/4, OF SECTION 13, TOWNSHIP 52 SOUTH, RANGE 41 EAST, LESS THE NORTHERLY 25 FEET THEREOF, LYING AND SITUATE IN MIAMI-DADE COUNTY, FLORIDA

PARCEL 4:

THE WEST 1/5 OF THE NORTH 1/2 OF THE SOUTHWEST 1/4 OF THE SOUTHEAST 1/4 OF THE NORTHWEST 1/4 OF SECTION 13, TOWNSHIP 52 SOUTH, RANGE 41 EAST, LESS THE NORTH 25 FEET THEREOF, KNOWN AS TRACT 386 OF SECTION "B" OF THE SUBDIVISION OF BISCAYNE GARDENS, UNRECORDED PLAT.

EXHIBIT "C"

**EXHIBIT "C" to the AGREEMENT between the CITY OF NORTH MIAMI and
TABERNACLE OF GLORY, INC.**

Date: 10/31/2023

**AGREEMENT for:
390 NW 161st Street,
Miami, FL 33160**

Tax Folio #: 30-2113-000-0180

City File: SC-

Legal Description of Customer's property:

See Exhibit "B"

Point of Connection to the City's sewer system:

**Sanitary Sewer Force Main
(FM) at NW 161st to Existing 8"
FM.**

ALLOCATED VOLUME:

**Proposed Sewer Flow - Two (2) Story Worship (Church with associated
improvements)** = **5940 gpd**

Existing sewer system is a Vacant Lot = **0 gpd**

Net Difference = **5940 gpd**

FEES TO BE PAID TO THE CITY:

Sewer Impact Fee (5940 gpd x \$2.79/gpd) = **\$ 16,572.60**

Sewer Administration Fee = **\$ 79.53**

Total Amount to be paid to City = **\$ 16,652.13**

EXHIBIT "C"

The installation of the following facilities shall be accomplished by the Customer and deeded to the City:

1. 16 LF of 4" C-900 FM

Other conditions: **As per Agreement**

APPROVAL:

By: City Manager:  Date: 11/21/23
Rasha Cameau, MBA, FRA-RP

By: City Engineer:  Date: 11/03/2023
Chuks U. Okereke



MEMORANDUM

To: Rasha Cameau, MBA, FRA-RP, City Manager

From: Wisler Pierre-Louis, P.E., Public Works Director 

Date: November 16, 2023

RE: SANITARY SEWER SERVICES AGREEMENT

This is the Sanitary Sewer Services Agreement between the **City of North Miami** and **Tabernacle of Glory, Inc.**

SANITARY SEWER SERVICES AGREEMENT

THIS WATER & SEWER SERVICES AGREEMENT ("Agreement") is made and entered this 22 day of November 2023, by and between the **CITY OF NORTH MIAMI**, a Florida municipal corporation ("City"), and **Tabernacle of Glory, Inc.** ("Customer").

WHEREAS, the City Water & Sewer Division of the Public Works Department has existing facilities, including but not limited to, sewer mains and improvements ("City Facilities") and Customer has constructed certain facilities, including but not limited to, sewer lateral and improvements, located in the clouded area on the attached Exhibit "A" that connect to the City Facilities. The facilities constructed by Customer are hereinafter referred to as the Facilities; and

WHEREAS, Customer owns property in unincorporated Miami-Dade County, which is more fully described in the legal description attached hereto as Exhibit "B" ("Customer's Property"); and

WHEREAS, the Customer desires to obtain sanitary sewer service ("Service") to Customer's Property utilizing the City Facilities; and

WHEREAS, the City desires to provide such Service upon the terms and conditions set forth herein.

NOW, THEREFORE, in consideration of the mutual promises contained herein, the parties agree as follows:

1. The Service shall be permitted by the City from the Customer's Property to the City Facilities, as described in Exhibit "A".
2. The complete plans and specifications must be approved by the City Engineer for Facilities to service the described area and the connection to the City Facilities ("Connection") shall be prepared by the Customer's Professional Engineer who shall be registered in the State of Florida. All construction shall be in strict conformity with the final plans and specifications as approved by the City's Engineer. The City, its engineer, or other representative, shall have the right to inspect any and all portions of the Facilities whether in Public Right-of-Way or on private property, and upon notification of any deviation from the approved plans and specifications, the

Customer shall immediately make modifications as directed by the City. No construction shall be commenced without final written approval of the plans and specifications by the City Engineer.

3. Customer will defend, indemnify, and hold the City harmless from any judgment, decree, order, demand, or claim (including costs or attorneys' fees), which in any way arises from Customer's negligence in performing this Agreement including the design and construction of the Facilities constructed by Customer, or from the act or omission of Customer or its agents. In addition, Customer shall, at all times, indemnify, defend and hold the City harmless from any and all loss, damage, cost or expense arising in any manner from Customer's obligations pursuant to this Agreement on account of the rights, privileges or conditions (contractual or otherwise), imposed by any federal, state or county agency. Nothing contained in this Agreement is, in any way, intended to be a waiver of the limitation placed upon the City's liability as set forth in Chapter 768, Florida Statutes. Additionally, the City does not waive sovereign immunity, and no claim or award against the City shall include attorney's fees, investigative costs or pre-judgment interest.

4. Ownership of such portions of the Facilities as are in the Public-Right-of-Way or across easements, shall be transferred to the City at such time as the City notifies the Customer that it is ready to accept such Facilities. Prior to such acceptance, all maintenance of the Facilities shall be by the Customer. At the time of acceptance by the City, the Customer shall furnish the City the following:

- a) An affidavit of Release of Lien for all materials, supplies and services.
- b) An executed Warranty Bond ("Bond") in the amount of one hundred ten percent (110%) of the value of the work constructed as estimated by the City, as protection to the City against losses and liabilities resulting from latent defects in materials or improper performances or work, which may appear or be discovered for a period of one (1) year from acceptance of the Facilities by the City. The Bond shall have as the surety only such companies as are authorized to write bonds of such character and amount under the laws of the State of Florida and with an agent in Miami-Dade County, Florida. Surety shall be rated by Best's Insurance Guide "A" or better. The Bond shall be in a form and amount to be approved by the City. The Bond shall expire upon the first-year anniversary of the City's acceptance of the Facilities.
- c) Certification by the Professional Engineer of Record that all Facilities were constructed in conformance with the approved documents and a certification as to the cost of the Facilities.

5. All costs relating to the Facilities including but not limited to labor, overhead, taxes, licenses application fees, easement acquisitions, lift stations, pumps pipes, materials, and any other direct or indirect costs related to installation of the Facilities shall be borne by the Customer and shall be fully paid by the Customer. All of City's costs in connection with the Facilities including but not limited to charges by the City's Engineer, the City's Attorneys' fees, inspections, maintenance, administrative expenses, and any other costs incurred by the City in connection with this matter shall be paid by the Customer. In addition to such costs, the Customer shall pay to the City a connection and/or tapping fee as shown in Exhibit "A". The City's connection fee and the City's costs shall be paid by the Customer within fifteen (15) days after being billed by the City. Any such billing by the City to the Customer shall be for items specified in the bill and may not necessarily cover all of the City's expenses, which shall be billed to the Customer separately. It is agreed that no reservation of capacity will be made by the City until all fees, set forth in Exhibit "A" have been paid. Payment of these fees shall in no way be construed as to relieve the Customer of its obligation to pay any further sums due in accordance with this Agreement that are charged subsequent to the completion of such connection.

6. In addition to all other charges set forth above, the Customer shall pay to the City a portion of all costs in connection with construction of the lines to which the Customer's Facilities are to be connected. This portion shall be indicated on Exhibit "A" as determined by the City. Payment shall be made by the Customer to the City within fifteen (15) days after billing by the City.

7. The Customer warrants and represents that it is either the owner of the Customer's Property described above or has the complete authority to act on behalf of the owner in executing this Agreement and that the terms hereof shall run with the land. It is acknowledged that this Agreement is for the purpose of providing a volume and rate of service to the Customer's Property described and that charges to be paid to the City for use of the City Facilities shall be charged to the ultimate user. Any increase in volume or rate of flow shall make this Agreement voidable on the part of the City. The City reserves the right to collect additional connection fees if the volume or rate of flow increases.

8. The design, installation and all future uses of the Facilities by the Customer or its successors or assigns shall be subject to the specific approval of the City of North Miami and where applicable, by all other governing authorities, including but not limited to Miami-Dade County, State of Florida, and the Miami-Dade Water & Sewer Authority, and there shall be no

subsequent modification or addition to the service to the Customer without the specific written consent of the City.

9. For the use of the City's system, the Customer shall pay a user rate established by the City Council of the City of North Miami, the billing to be issued by the City and paid by the Customer on a basis as the City customarily bills. The Customer shall, immediately upon demand pay to the City a non-interest bearing deposit as determined by the City. Upon failure of the Customer to immediately pay the periodic charges for service, the deposits shall immediately forfeit to the City. The City shall have the right to adjust its service rates to reflect current or future costs, and the Customer agrees to pay all such lawfully imposed rates, pursuant to City Code of Ordinances and applicable state laws.

10. Such parts of the system that are on the Customer's property shall at all times be maintained and repaired by the Customer; however, the City shall have the right to inspect such Facilities and the Customer, upon the City's written direction, shall make such repairs and maintenance as City directs.

11. If sewer service is covered by this Agreement, the Customer agrees that it shall not discharge or cause to be discharged into the sewer lines any of the following described waters or waste:

- a) Any surface drainage water or ground water infiltration.
- b) Any gasoline, benzene, naphtha, fuel oil or other inflammable or explosive liquid, solid or gas.
- c) Any noxious or malodorous gas or substances, which either singly or by interaction with other wastes, is capable of creating a public nuisance or hazard to life or preventing maintenance and repair of the lines or connecting lines and treatment facility.
- d) Any waters or waste containing toxic or poisonous substances in sufficient quantity to constitute a hazard to any structures and appurtenances of the lines and connecting lines and treatment facility, humans or animals or create any hazard or aesthetically undesirable conditions within or without lines and connecting lines and treatment facility. Such materials shall include, but shall not be limited to:
 - (1) Any cyanides in excess of two (2) milligrams per liter as (ON).
 - (2) Phenols in excess of three hundred (300) milligrams per liter by weight.

- (3) Hydrogen sulfide or sulfur dioxide in excess of ten (10) milligrams per liter by weight in sewage.
- (4) Iron in excess of twenty-five (25) mg. per liter.
- (5) Chromium in excess of ten (10) mg. per liter.
- (6) Copper in excess of ten (10) mg. per liter.
- (7) Zinc in excess of ten (10) mg. per liter.
- (8) Nickel in excess of ten (10) mg. per liter.
- (9) Biochemical oxygen demand in excess of two hundred (200) ppm.
- (10) Chlorine demand in excess of 50 ppm.

12. Whenever the term "parts per million by weight" is used, it means equivalent to "milligrams per liter," when reported in laboratory analysis results. The methods of analysis shall conform to Standard Methods for the Examination of Water and Waste Water, Eleventh Edition as published by the American Public Health Association. The quality limitations of this article shall apply to concentrations or other physical characteristics obtained by analysis of a composite sample of the waters or water collected for a 24-hour period, proportioned to flow. Periodic quality control tests shall be performed by chemists hired by the Water and Sewer Department of the City at the Customer's reasonable expense. The City may, from time to time, impose additional reasonable restrictions on the quality of discharge into the lines. The Customer further agrees to meet any and all regulations and conditions that may be required by future or existing contracts between the City and the State of Florida or Miami-Dade County, as well as meeting all requirements of Miami-Dade County Ordinance No.96-166. Customer agrees that in addition to any remedies provided for in the Ordinance No.96-166, the City may terminate any water and sewer service until the violation by the Customer is corrected to the satisfaction of the City.

13. The route of the lines from the Customer's property to the City's system shall be as determined by the City, and the Customer shall obtain, at its own expense, upon direction by the City any and all easements necessary which easements shall be in favor of the City of North Miami.

14. Any temporary cessation of the service by the City caused by an act of God, fire, strike, casualty, necessary maintenance work, breakdown of/or injuries to machinery, pumps or pipe lines, civil or military authority, insurrection, riot or any other unforeseeable circumstance, shall not constitute a breach of this Agreement on the part of the City, and the City shall not be liable to the Customer for any damage resulting from such cessation of service. The City shall not be responsible to the Customer for any backup, interruption of service, or any difficulty in the

discharge of the Customer's sewage into the City's sewage Facilities due to a cause beyond the City's control or otherwise.

15. Within the limits of F.S. Section 768.28, the Customer agrees to hold and save harmless the City for any litigation and/or damages including attorneys' fees and court costs resulting from the inclusion into the lines of the City's sewage Facilities of any substance in violation of the provisions of this Agreement, or resulting from any violation by the Customer of any of the provisions of this Agreement. In the event of any violation by the Customer of any of the provisions of this Agreement (other than the payment of money by the Customer to the City), the City shall give the Customer notice and the Customer shall rectify said violation within fourteen (14) days after such notice (if such violation is reasonably susceptible of correction within fourteen days, otherwise the Customer shall commence the correction within this period and complete the correction without delay). If the violation is of such emergency nature as reasonable warrants immediate corrective action, the City may, at its option, undertake and complete, concurrent with written notice to the Customer, such emergency action as the circumstances warrant, and any reasonable expense incurred by the City shall be paid by the Customer. In the event it becomes necessary for the City to enforce any provision of this Agreement by court action or otherwise, and the City prevails, the Customer will pay all of the City's costs, including attorney's fees, at all levels, including any appeals.

16. Where necessary, any approvals of this Agreement by any governmental agency shall be obtained by the Customer at Customer's expense, including where necessary, inclusion of the Customer's Property in the service area of the City. The City will cooperate with the Customer, at the Customer's expense, in obtaining any such approvals as are necessary.

17. All notice required shall be by certified mail, return receipt requested, to the Customer and to the City, addressed to : City Manager at 776 N.E. 125 Street, North Miami, Florida 33161 with a copy to the City Attorney at the same address.

18. This Agreement shall be binding upon the parties herein, their heirs, partners, executors, legal representatives, successors and assigns. Chapter 19 of the Code of Ordinances of the City of North Miami and Ordinance No. 811 as they apply to the Water and Sewer Enterprise of the City as presently existing and as may be amended in the future shall be deemed included as part of this Agreement. Any modification of this Agreement or any waiver or extension must be approved, in writing, by both parties.

19. The Customer agrees to dedicate to the City an easement, as to be determined by the City, so as to allow the City to enter the subject property and make such alterations, repairs, or other work to the Facilities, as the City shall deem necessary to achieve efficient Service. Any easement shall be dedicated to the City and so recorded at the Miami-Dade County Courthouse within ten (10) days of the signing of this Agreement, at Customer's expense.

20. If, at the time of execution, the property served pursuant to this Agreement is located within the unincorporated area of Miami-Dade County, Customer agrees that if the owner of the property attempts or allows such property now or in the future to be annexed or considered for annexation into any municipality, then in such event, the Customer grants to the City of North Miami, the right of first refusal to be the sole municipality to which the land will be annexed.

21. This Agreement shall be recorded by the Customer at its expense in the Public Records of Miami-Dade County in order to give notice to any successor in interest of the provisions of this Agreement. This Agreement shall run with the land of Customer as described in Exhibit "A".


[The remainder of this page is intentionally left blank.]

IN WITNESS WHEREOF, the parties have executed this Agreement by their respective proper officers duly authorized the day and year first written above.

CORPORATE ACKNOWLEDGMENT

ATTEST:

Corporate Secretary or Witness:

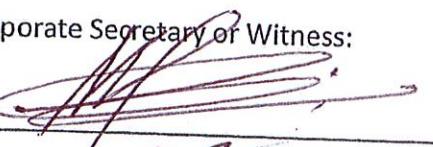By: 

Print Name: MAGGIE Dumay

Date: 11/07/2023

Tabernacle of Glory:

"Customer":

By: 


Print Name: CAINGHI GUERRIER

Date: 11/07/23

STATE OF FLORIDA)

COUNTY OF MIAMI-DADE)

The foregoing instrument was acknowledged before me this 11 day of Nov., 2023,
by CAINGHI GUERRIER, who is personally known to me, or who has
produced _____ as identification.

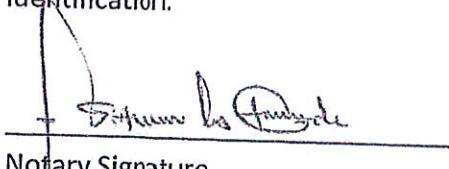

Notary Signature

Jean Claude Fortilus
Print Name

Notary Public – State of Florida

Commission No: HH178992

My Commission Expires: 09-25-2025

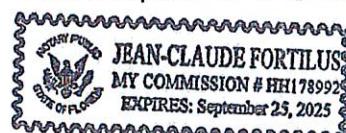

CITY ACKNOWLEDGMENT

ATTEST:

By: 


Vanessa Joseph, Esq.
City Clerk

City of North Miami, a Florida municipal
Corporation: "City"

By: 

Rasha Cameau, MBA, FRA-RP
City Manager

APPROVED AS TO FORM AND
LEGAL SUFFICIENCY:

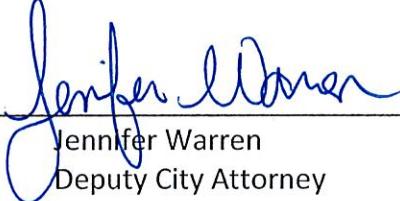
By: 

Jennifer Warren
Deputy City Attorney

STATE OF FLORIDA)

COUNTY OF MIAMI-DADE)

The foregoing instrument was acknowledged before me this 21 day of November, 2023,
by Rasha Cameau, who is personally known to me or who has
produced _____ as identification.

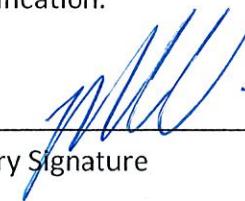

Notary Signature

Mariu Nava
Print Name

Notary Public – State of Florida

Commission No: HH 042945

My Commission Expires: 9/26/2024

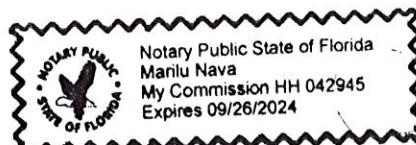

ENGINEER ACKNOWLEDGMENT

BY: Chuks
Chuks U. Okereke
City Engineer
City of North Miami

STATE OF FLORIDA)
COUNTY OF MIAMI-DADE)


The foregoing instrument was acknowledged before me this 16th day of November, 2023,
by Chuks U. Okereke, who is personally known to me or who has
produced _____ as identification.

Frantzy Daniel
Notary Signature

Print Name

Notary Public – State of Florida

Commission No: HH248415

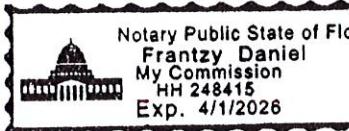

My Commission Expires: 4/1/2026